

PREPARED FOR
DIANE COCROFT
KEEFE REAL ESTATE
751 GENEVA PARKWAY
LAKE GENEVA, WI 53147



PLAT OF SURVEY

-OF-

LOTS 3821 THRU 3828, BLOCK 66 IN LAKE COMO BEACH
SUBDIVISION, LOCATED IN T. 2. N, R. 17. E, GENEVA TOWNSHIP,
WALWORTH COUNTY, WISCONSIN

KROTT SURVEYING INC.

N3705 WILLOW BEND LANE
LAKE GENEVA WI. 53147
PHONE # (262)248-3697
FAX # (262)249-0639

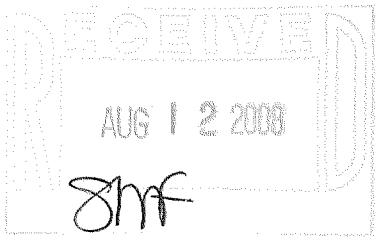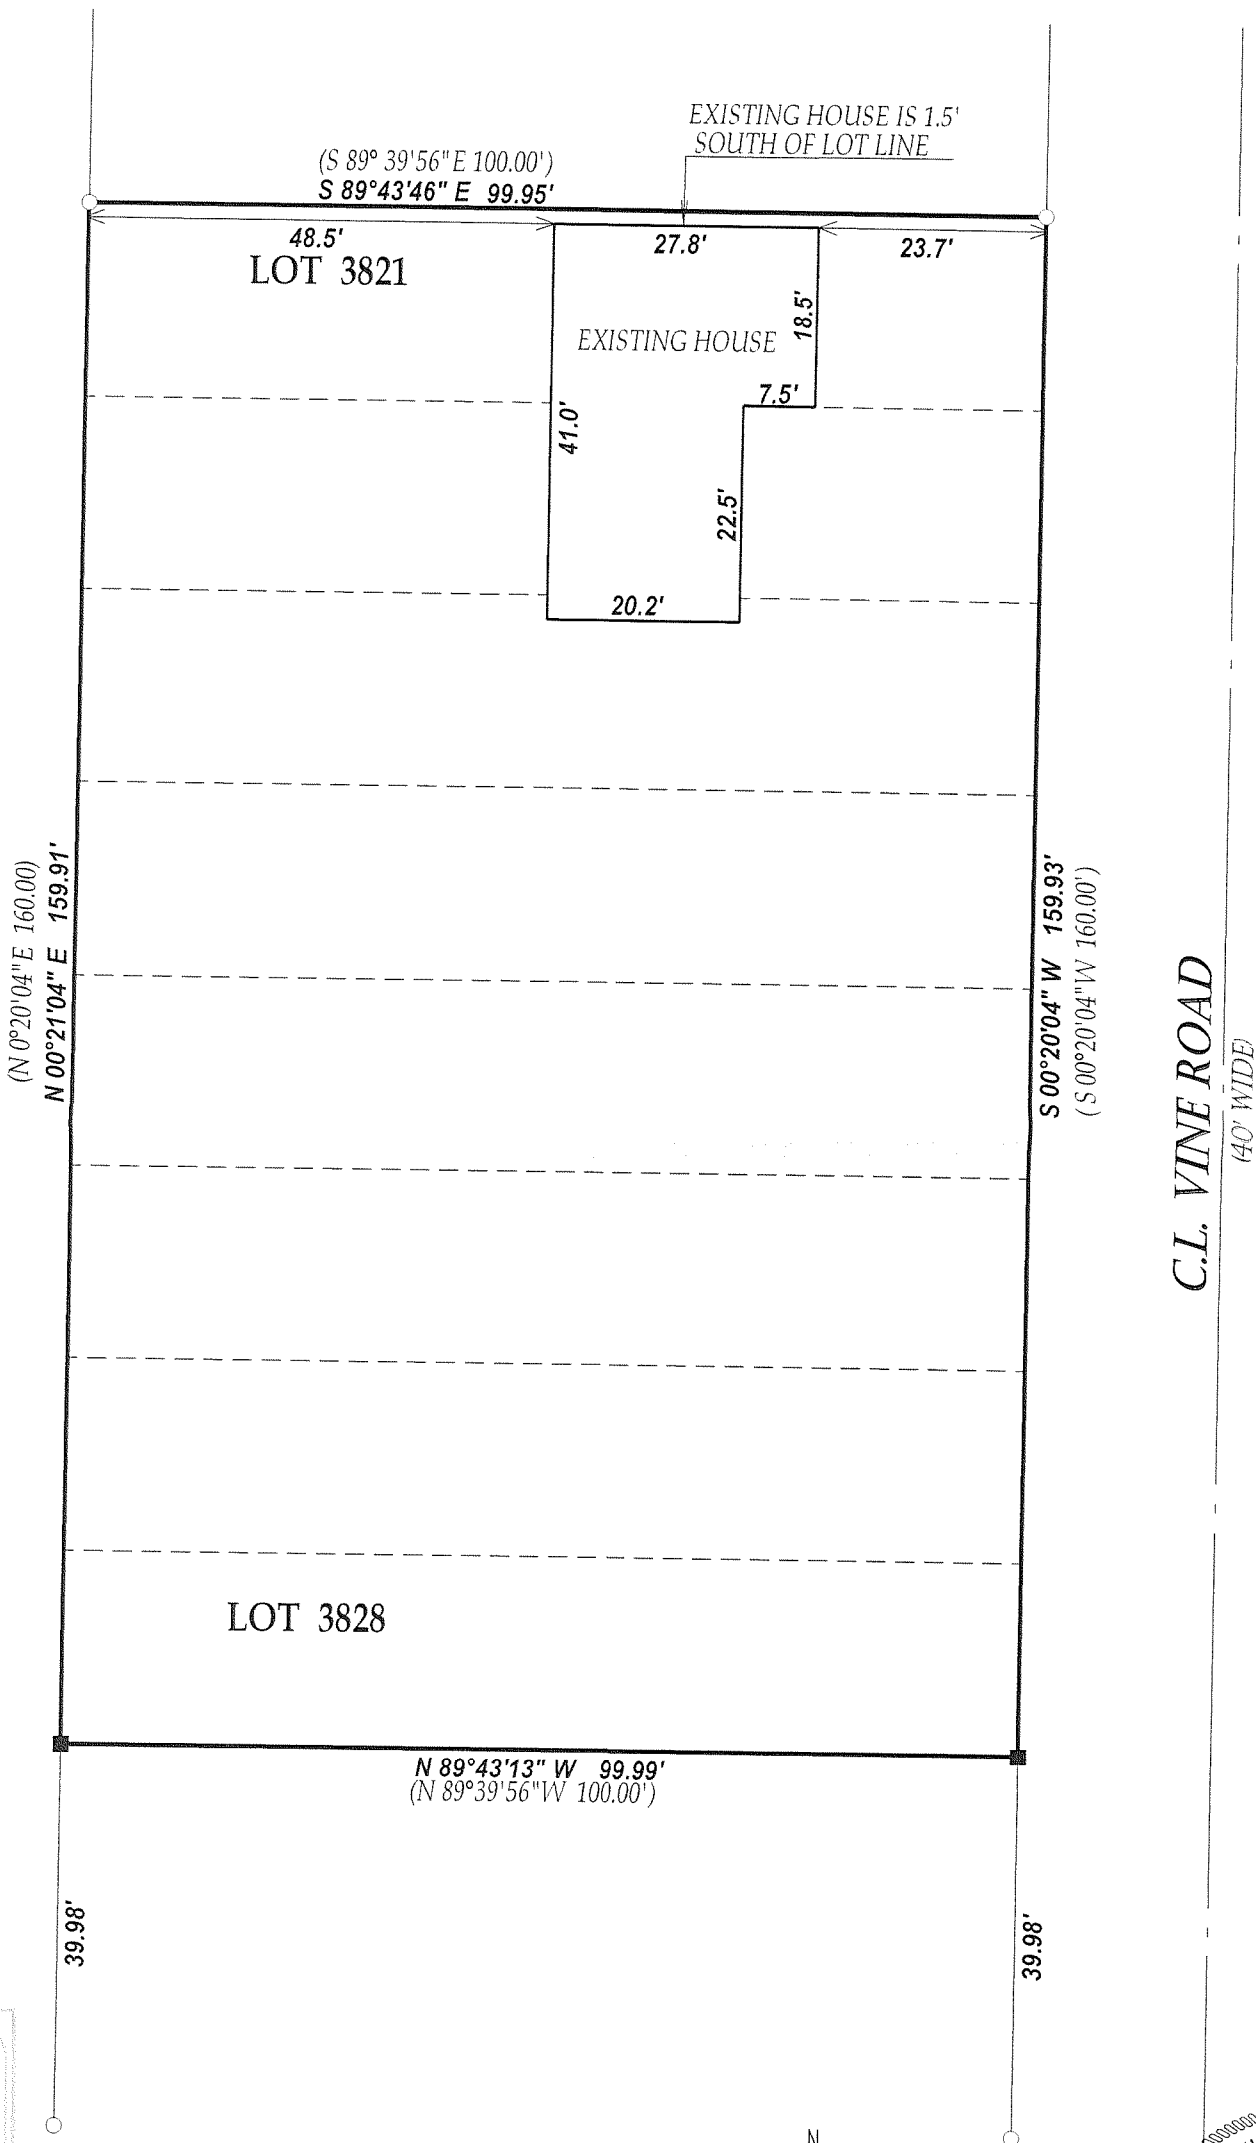


LEGEND

- FOUND IRON PIPE
- SET IRON BAR



(xx) RECORDED AS

JOB # 08-123 TAXID # JLCB 00727
DATED THIS THE 10TH DAY OF JUNE 2008

SCALE 1" = 20'

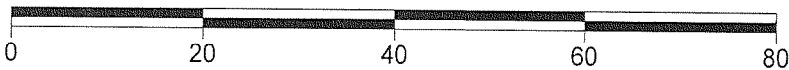

"I hereby certify that I have surveyed the above described property and that the above map is a true representation thereof and shows the size and location of all visible structures, apparent easements and encroachments if any."
This survey is made for the present owners of the property, and those who purchase, mortgage, or guarantee the title thereto, within one year from the date hereof.

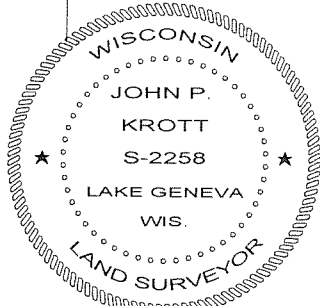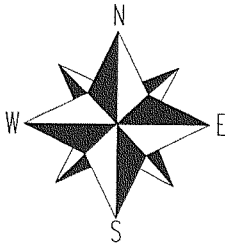

John P. Krott
JOHN KROTT S - 2258
Wisconsin Registered Land Surveyor
(original if signed in red)

217-3503