
PLAT OF SURVEY

-OF-

KROTT SURVEYING INC. N3705 WILLOW BEND LANE LAKE GENEVA WI. 53147 PHONE # (262)248-3697 FAX # (262)249-0639

LOTS 47 THROUGH 52, INCLUSIVE, IN THE GUMMOW ADDITION, ACCORDING TO THE PLAT THEREOF RECORDED IN THE OFFICE OF THE REGISTER OF DEEDS IN AND FOR WALWORTH COUNTY, WISCONSIN. SAID LAND BEING IN THE TOWN OF GENEVA, COUNTY OF WALWORTH, STATE OF WISCONSIN. TOGETHER WITH THE WEST 1/2 OF THE VACATED ALLEY ABUTTING THE ABOVE-DESCRIBED PREMISES.

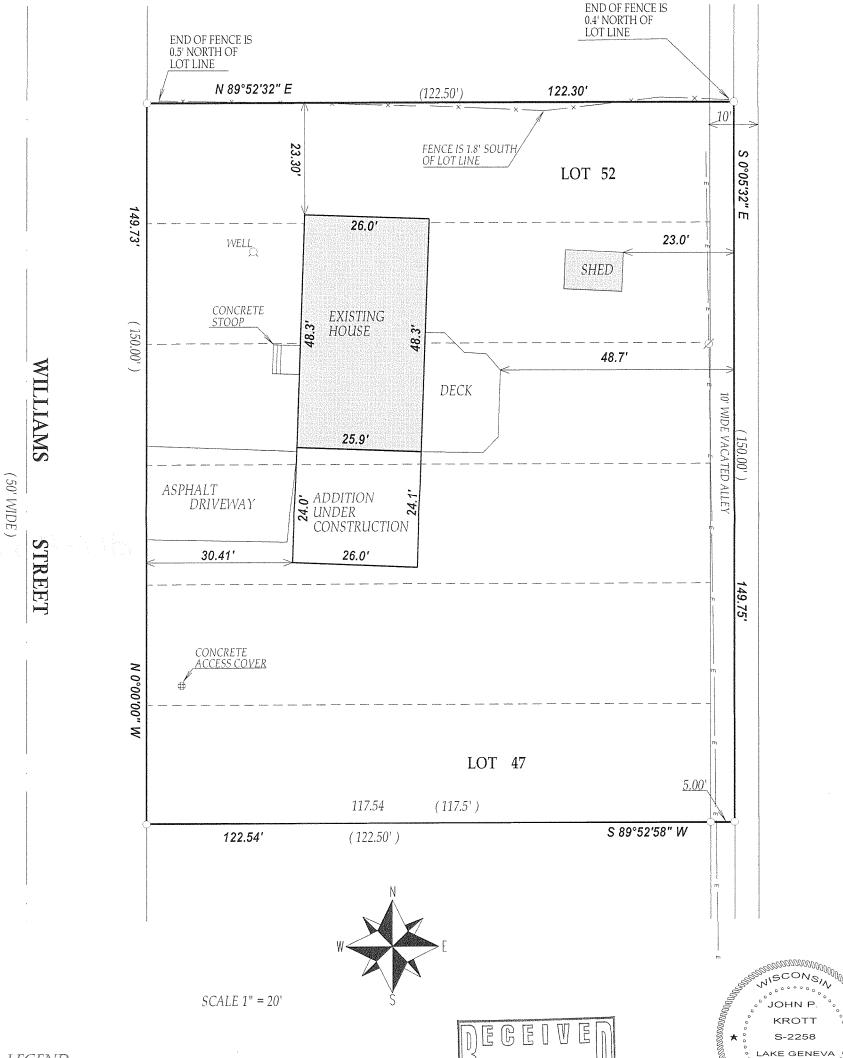

LEGEND OVER HEAD UTILITIES

- Ø UTILITY POLE
- O FOUND IRON PIPE
- □ FOUND IRON BAR
- SET IRON BAR

(XX) RECORDED AS

JOB # 09-062AB TAX ID **∜** JGUM00011B

"I hereby certify that I have surveyed the above described property and that the above map is a true representation thereof and shows the size and location of all visible structures, apparent easements and encroachments

This survey is made for the present owners of the property, and those who purchase, mortgage, or guarentee the title thereto, within one year from the date hereof.

DODO SURVE SE DATE OF LAST REVISION: 7/21/2009

WIS.

TWO SURVE

DATED THIS 29th, DAY OF MAY, 2009

JOHN KROTT S - 2258 Wisconsin Registered Land Surveyor

(original if signed in red)