
PREPARED FOR: BASSO BUILDERS 403 SKYLINE DR LAKE GENEVA, WI 53147


PLAT OF SURVEY


-OF-

LOTS 4983 THRU 4987, BLOCK 87, LAKE COMO BEACH A SUBDIVISION, LOCATED IN TOWN 2 NORTH, RANGE 17 EAST, WALWORTH COUNTY, WISCONSIN.

KROTT SURVEYING INC.
N3705 WILLOW BEND LANE
LAKE GENEVA WI. 53147
PHONE # (262)248-3697
FAX # (262)249-0639

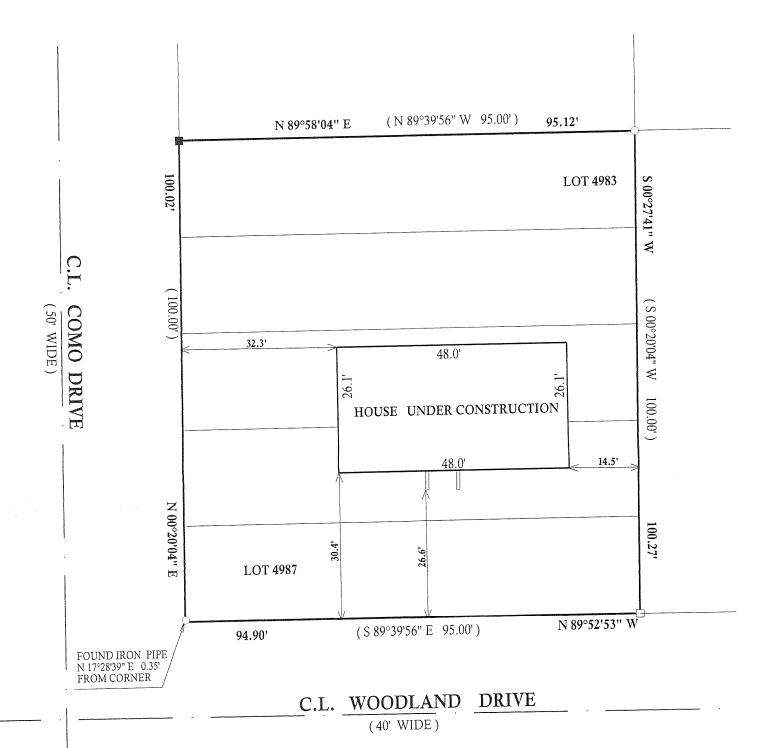

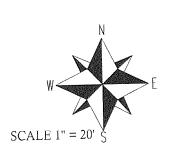

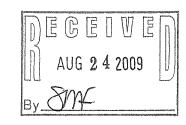



- O FOUND IRON PIPE
- ☐ FOUND IRON BAR
- SET IRON BAR

(XX) RECORDED AS

JOB # 09-064AB TAX ID # JLCB00995

"I hereby certify that I have surveyed the above described property and that the above map is a true representation thereof and shows the size and location of all visible structures, apparent easements and encroachments if any."

if any."

This survey is made for the present owners of the property, and those who purchase, mortgage, or guarentee the title thereto, within one year from the date hereof.



DATE OF LAST REVISION: 7 / 06 / 2009

DATED THIS 2nd, DAY OF MAY, 2009

FOR BLAND ST. S. 2258

JOHN KROTT S - 2258 Wisconsin Registered Land Surveyor (original if signed in red)

217-3579