


FEB 02 2010

X:\Projects\7874\DCAD\ASBUILT

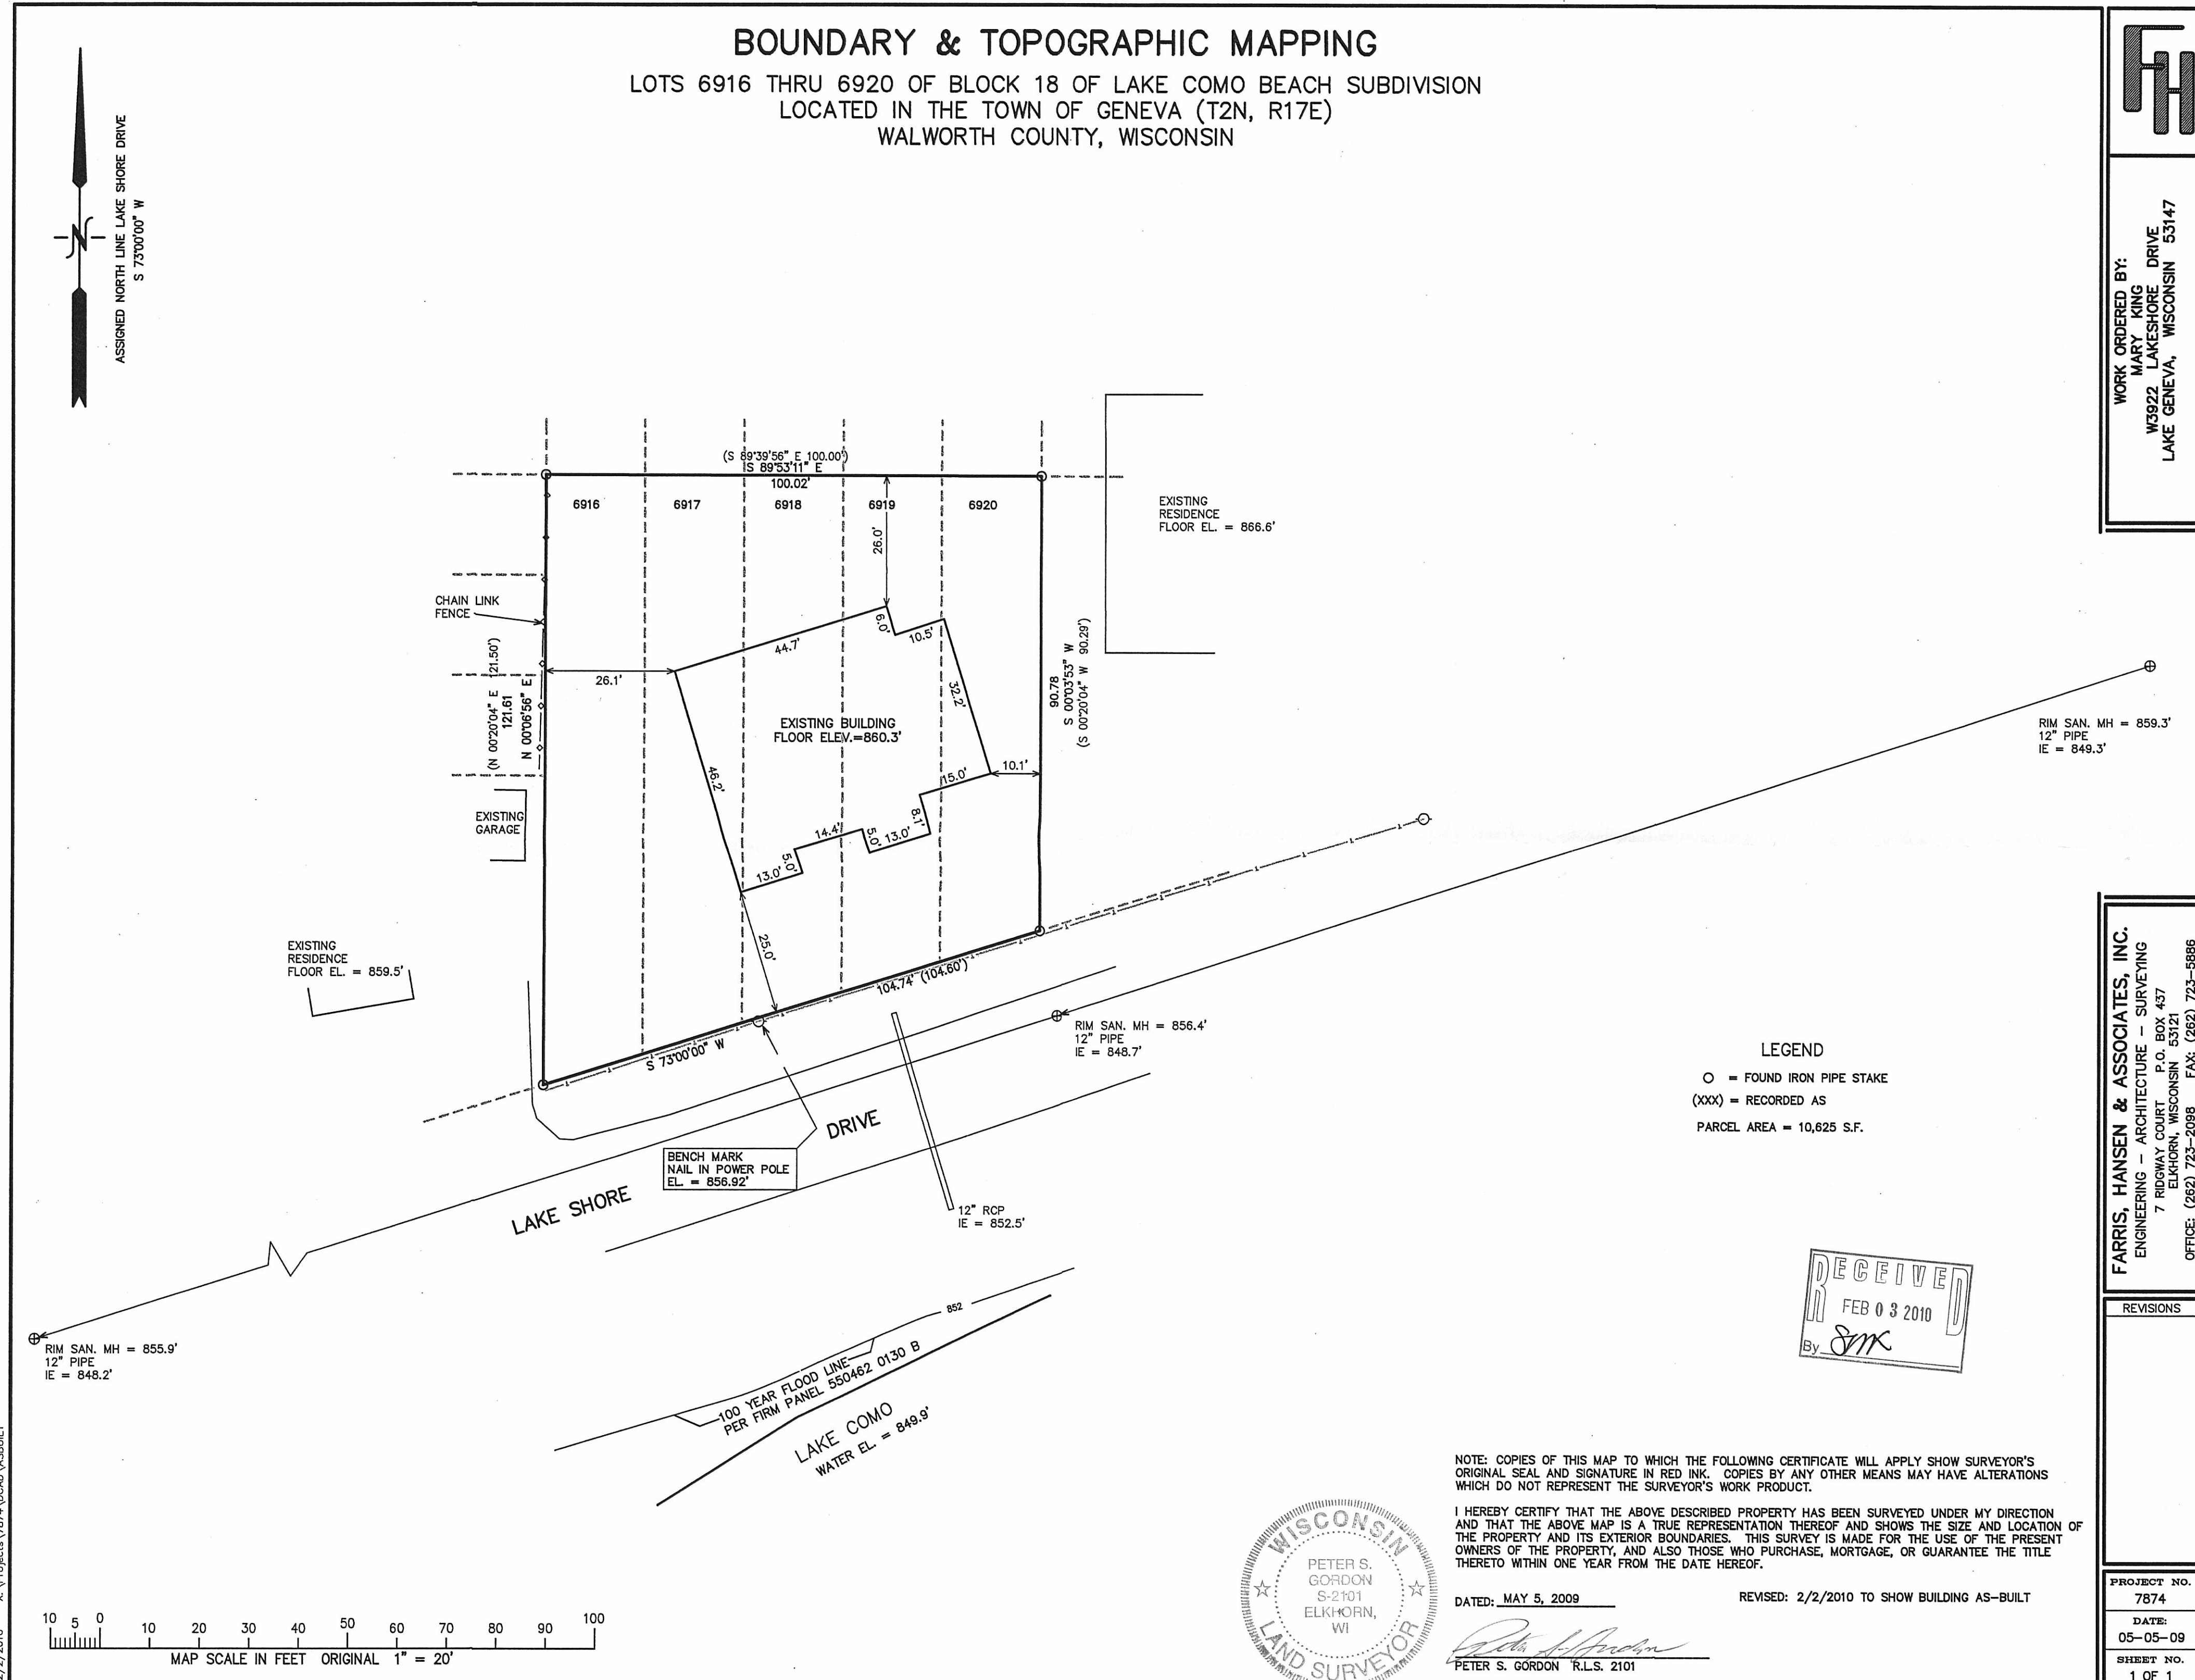

JLOB 1457

217-3608