

PLAT OF SURVEY

LOTS 7558 THRU 7562, BLOCK 129, LAKE COMO BEACH SUBDIVISION, GENEVA TOWNSHIP,
WALWORTH COUNTY, WISCONSIN.




STATE OF WISCONSIN
COUNTY OF ROCK SS.

I HEREBY CERTIFY THAT I HAVE SUPERVISED THE SURVEY OF THE PROPERTY DESCRIBED ABOVE
FOR THE EXCLUSIVE USE OF WELLNITZ & SAROW BUILDERS, INC. AND THAT TO THE BEST OF MY
KNOWLEDGE AND BELIEF THE PLAT HEREON DRAWN CORRECTLY REPRESENTS SAID SURVEY
AND ITS LOCATION.

GIVEN UNDER MY HAND AND SEAL THIS 26TH DAY OF AUGUST, 2009, AT JANESVILLE, WISCONSIN.
REVISED THIS 27TH DAY OF AUGUST, 2009.
REVISED THIS 3RD DAY OF SEPTEMBER, 2009
REVISED THIS 13TH DAY OF NOVEMBER, 2009

Steven Lathrop
Steven Lathrop
R.L.S. Number 1853

If the surveyor's signature is not
red in color, the map is a copy and
may contain unauthorized alterations.
The certification contained hereon
shall not apply to any copies.

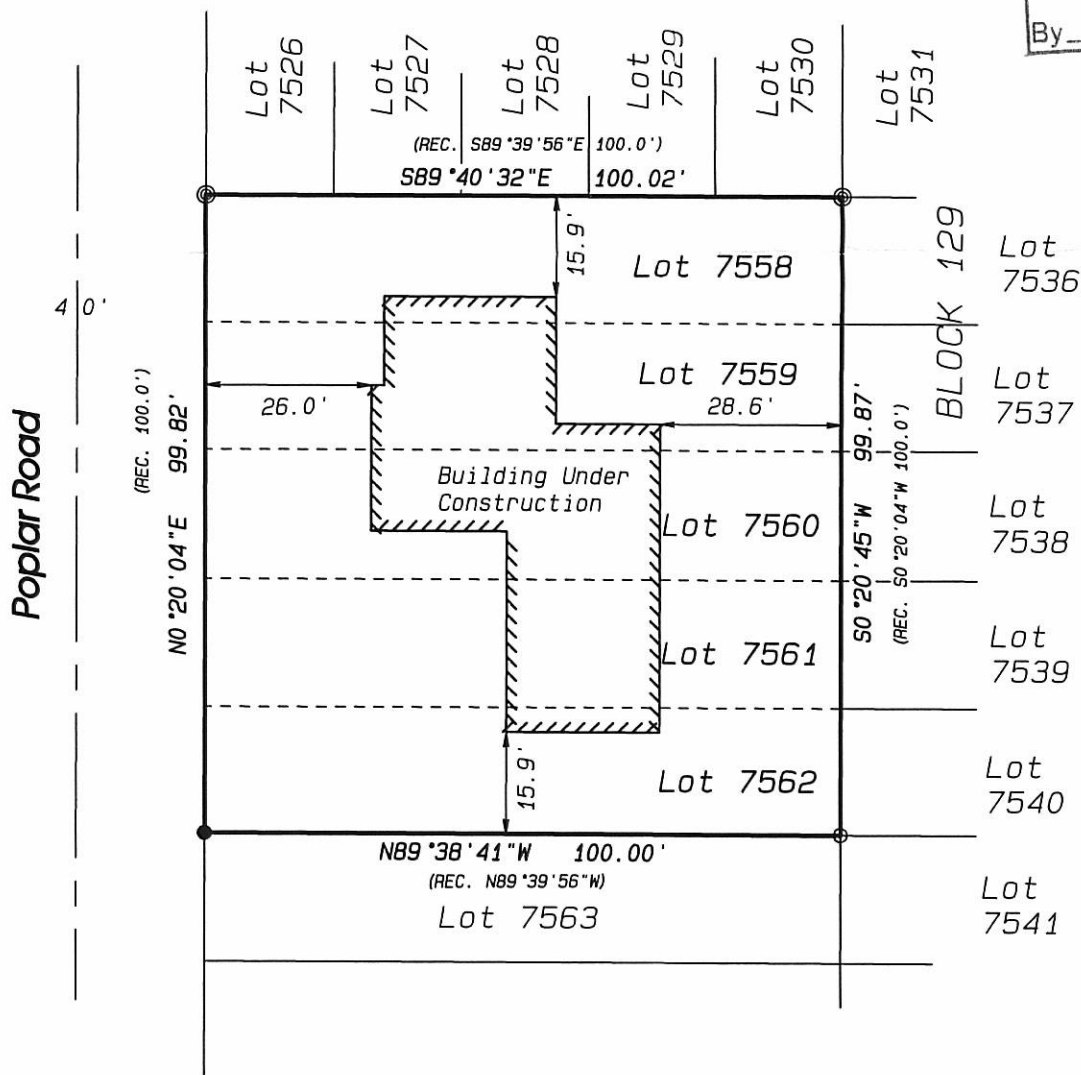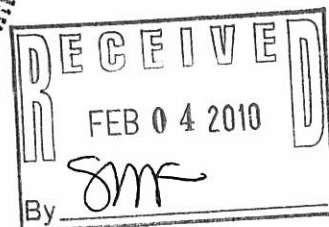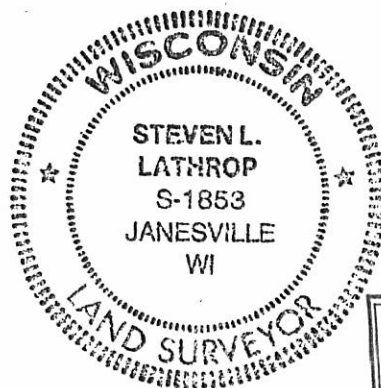

LEGEND:

○ FOUND 7/8" ROUND IRON REBAR

NOTES:

