
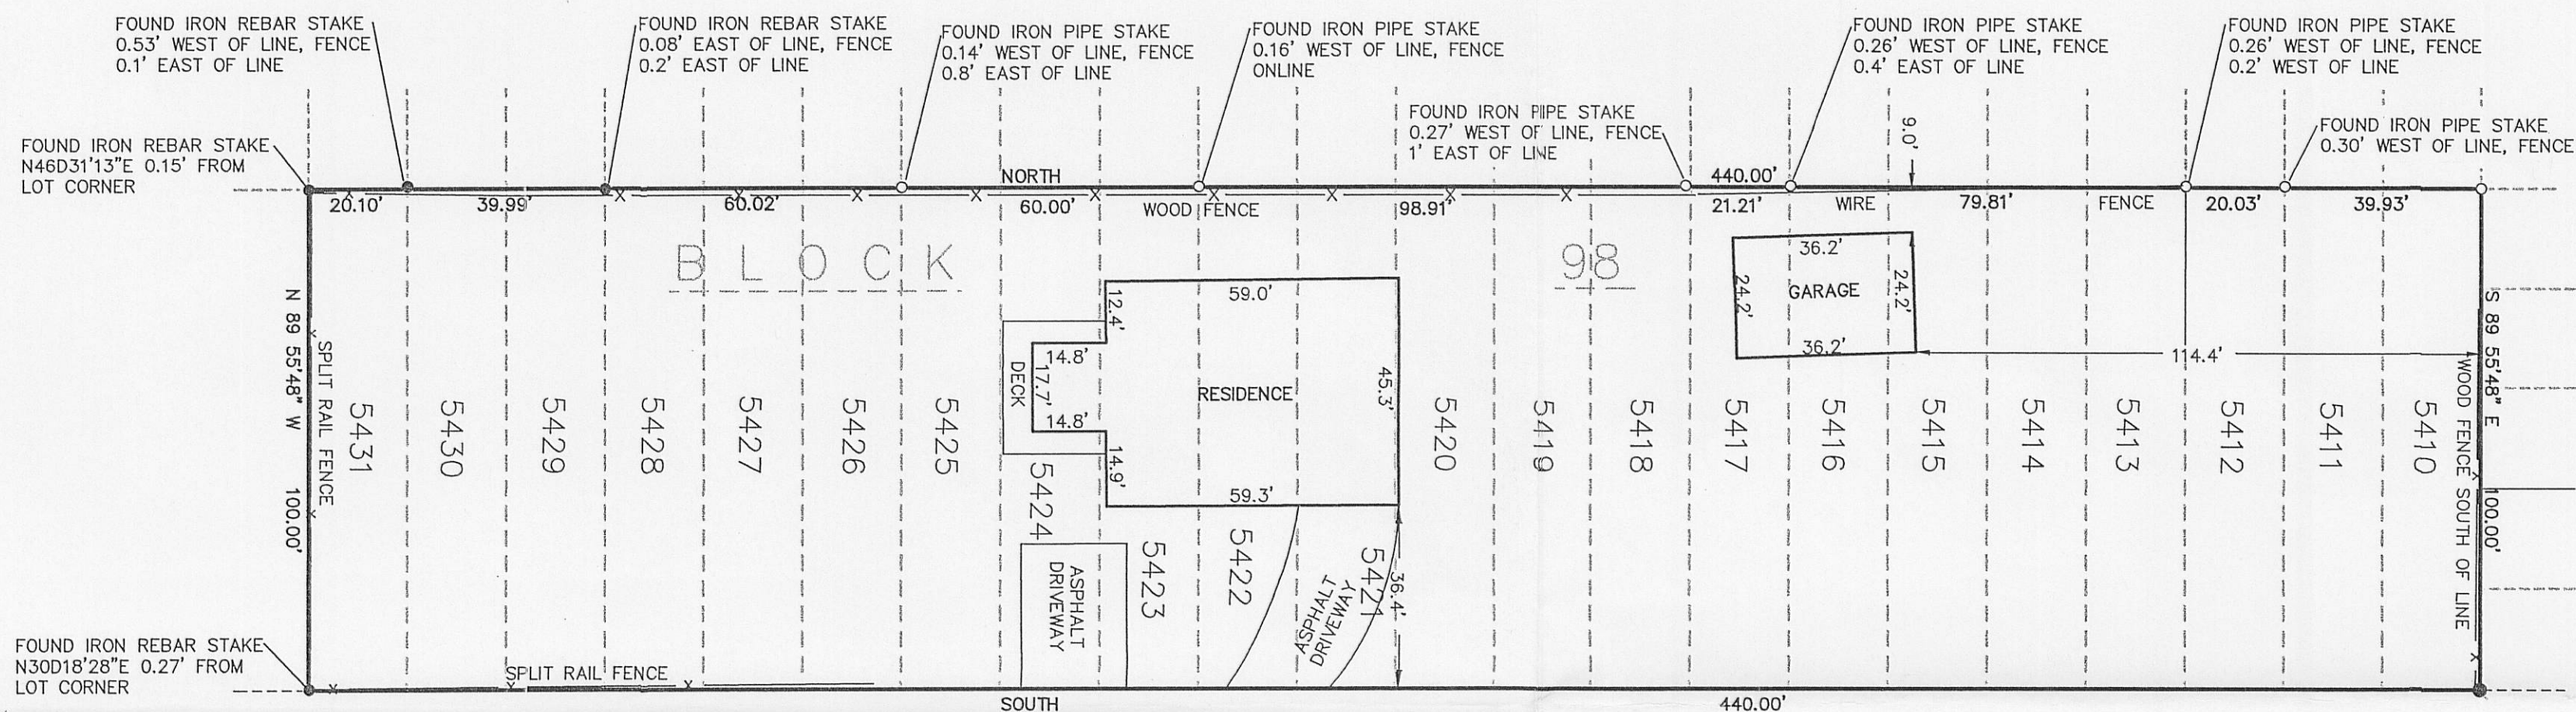



PLAT OF SURVEY

LOTS 5410 THRU 5431 BLOCK 98
LAKE COMO BEACH, A SUBDIVISION
LOCATED IN THE NE 1/4 SECTION 28
TOWN 2 NORTH, RANGE 17 EAST
WALWORTH COUNTY, WI.

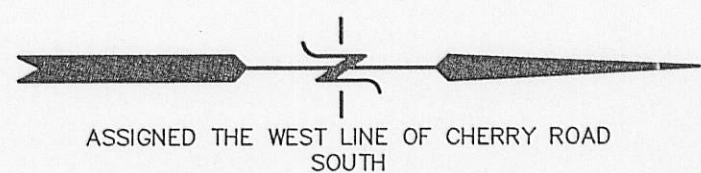

- LEGEND
- SET IRON REBAR STAKE
 - FOUND IRON REBAR STAKE
 - FOUND IRON PIPE STAKE
 - (XXX)—RECORDED AS

TOTAL AREA: 43,999 SQ. FT.

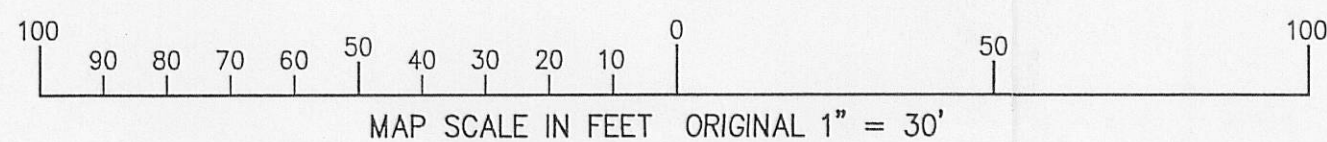



CHERRY ROAD

NOTE: COPIES OF THIS MAP TO WHICH THE FOLLOWING CERTIFICATE WILL APPLY SHOW SURVEYOR'S ORIGINAL SEAL AND SIGNATURE IN RED INK. COPIES BY ANY OTHER MEANS MAY HAVE ALTERATIONS WHICH DO NOT REPRESENT THE SURVEYOR'S WORK PRODUCT.

I HEREBY CERTIFY THAT THE ABOVE DESCRIBED PROPERTY HAS BEEN SURVEYED UNDER MY DIRECTION AND THAT THE ABOVE MAP IS A TRUE REPRESENTATION THEREOF AND SHOWS THE SIZE AND LOCATION OF THE PROPERTY AND ITS EXTERIOR BOUNDARIES. THIS SURVEY IS MADE FOR THE USE OF THE PRESENT OWNERS OF THE PROPERTY, AND ALSO THOSE WHO PURCHASE, MORTGAGE, OR GUARANTEE THE TITLE THERETO WITHIN ONE YEAR FROM THE DATE HEREOF.

DATED: SEPT. 13, 2010

Peter S. Gordon
PETER S. GORDON R.L.S. 2101

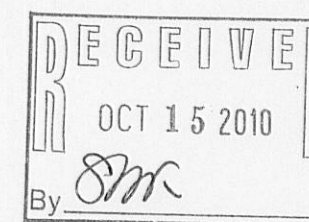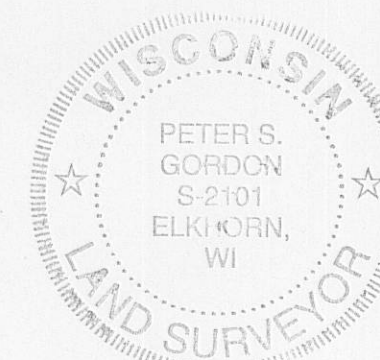

WORK ORDERED BY:
PATRICIA VICKERY
N3177 CHERRY ROAD
LAKE GENEVA, WI. 53147

FARRIS, HANSEN & ASSOCIATES, INC.
ENGINEERING - ARCHITECTURE - SURVEYING
7 RIDGWAY COURT P.O. BOX 437
ELKHORN, WISCONSIN 53121
OFFICE: (262) 723-2098 FAX: (262) 723-5886

REVISIONS

PROJECT NO.
8221
DATE:
09-13-2010
SHEET NO.
1 OF 1