

PREPARED FOR:
BASSO BUILDERS
403 SKYLINE DR
LAKE GENEVA, WI 53147



PLAT OF SURVEY

-OF-

LOTS 2768-2775, BLOCK 48 OF LAKE COMO BEACH SUBDIVISION,
LOCATED IN SECTIONS 22 AND 27, T2N, R17E, WALWORTH
COUNTY, WISCONSIN.

KROTT SURVEYING INC.

N3705 WILLOW BEND LANE
LAKE GENEVA WI. 53147
PHONE # (262)248-3697
FAX # (262)249-0639

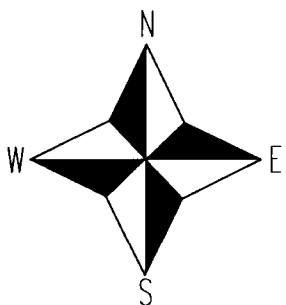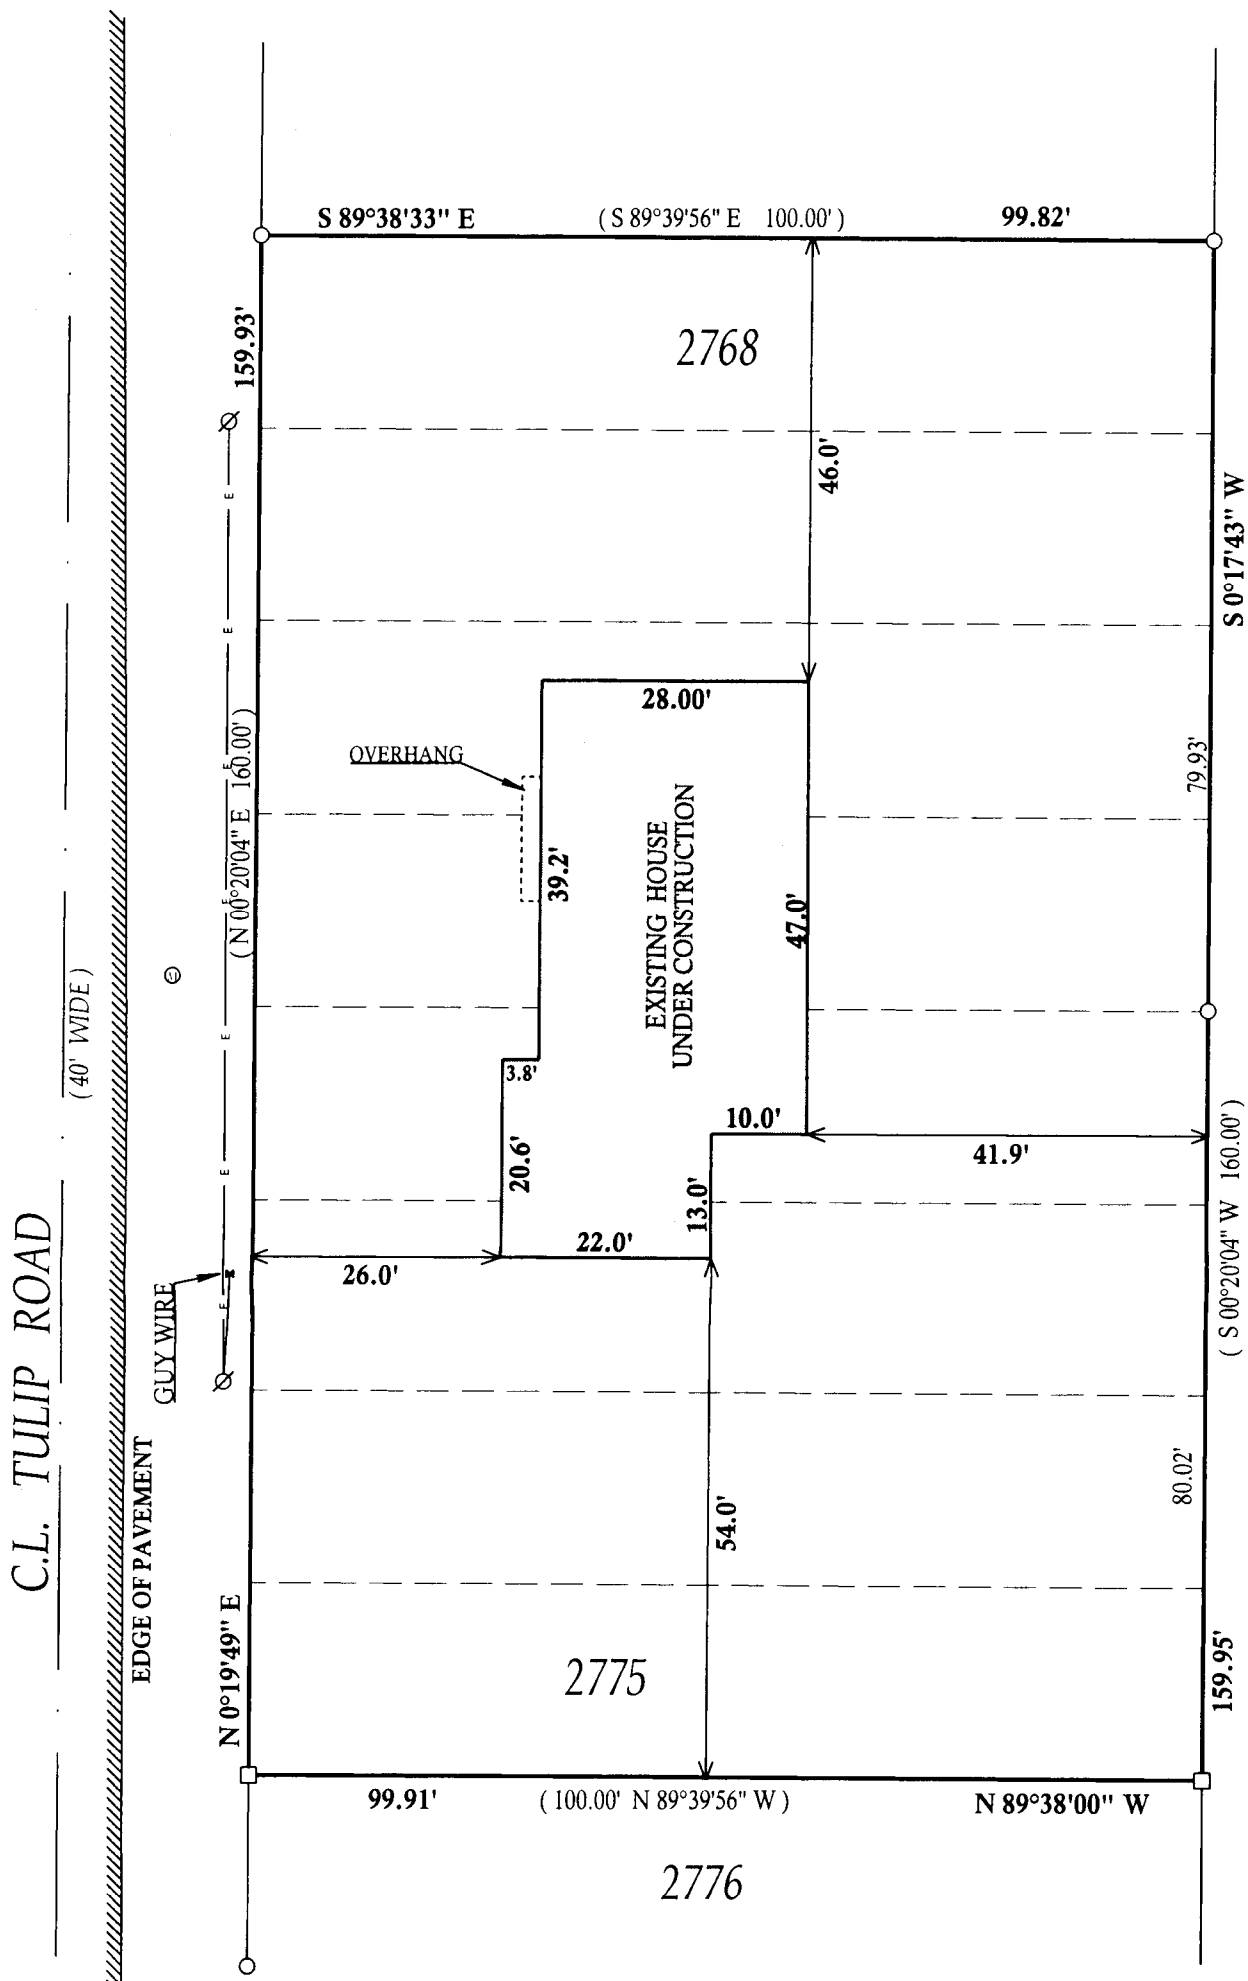

LEGEND


- FOUND IRON PIPE
- FOUND IRON BAR
- ⊙ MAIL BOX
- ⊗ UTILITY POLE
- OVERHEAD WIRES

(XX) RECORDED AS

TAX ID # JLCB00483



JOB # 03-155AB

SCALE 1" = 20'

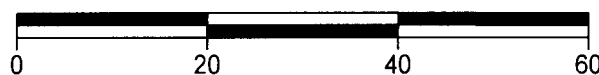

I have surveyed the above-described property and the above map is a true representation thereof and shows the size and location of the property, its exterior boundaries, the location and dimensions of all structures thereon, fences apparent easements and roadways and visible encroachments, if any.

This survey is made for the exclusive use of the present owners of the property, and also those who purchase, mortgage, or insure the title thereto within one (1) year from date hereof; and as to them I warrant the accuracy of said survey map.

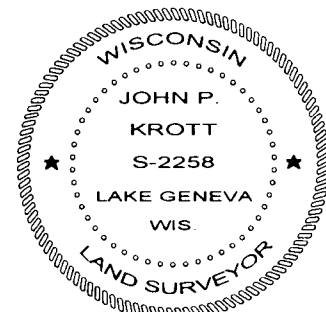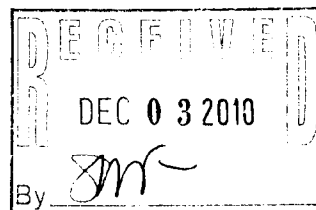

DATED THIS 23rd, DAY OF AUGUST, 2010
DATE OF LAST REVISION 10 / 27 / 2010
REVISED 09 / 28 / 2010

JOHN KROTT S - 2258
Wisconsin Registered Land Surveyor
(original if signed in red)

217-3686