PREPARED FOR ANN DILLA N 3380 ELFIN PLACE LAKE GENEVA WI. 53147

PLAT OF SURVEY


-OF-


THE NORTH 1/2 OF LOT 9612 AND ALL OF LOTS 9613 THRU 9619, BLOCK 173, LAKE COMO BEACH SUBDIVISION, LOCATED IN TOWN 2 NORTH, RANGE 17 EAST, WALWORTH COUNTY, WISCONSIN.

KROTT SUR VEYING INC.

N3705 WILLOW BEND LANE
LAKE GENEVA WI. 53147
PHONE # (262)248-3697

FAX # (262)249-0639

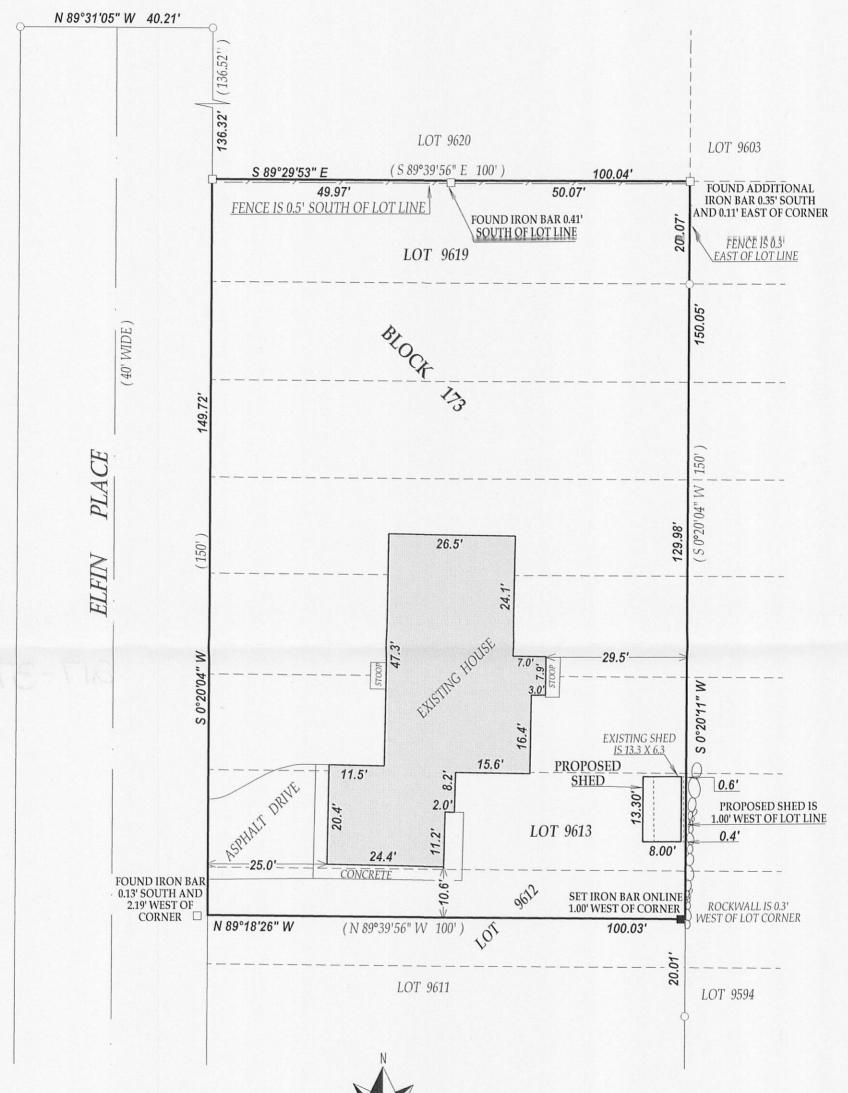


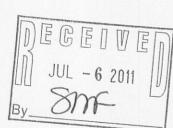

LEGEND

- O FOUND IRON PIPE
- □ FOUND IRON BAR
- SET IRON BAR

(xx) RECORDED AS TAX ID # JLCB02073 JOB # 11-059

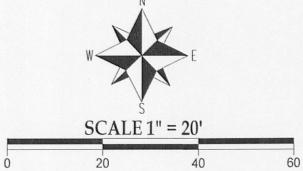

I have surveyed the above-described property and the above map is a true representation thereof and shows the size and location of the property, its exterior boundaries, the location and dimensions of all structures thereon, fences apparent easements and roadways and visible encroachments. if any.

This survey is made for the exclusive use of the present owners of the property, and also those who puchase, mortgage, or insure the title therto within one (1) year from date hereof; and as to them I warrant the accuracy of said survey map.

NOTE: BEARINGS ARE REFRENCED TO THE RECORD PLAT OF LAKE COMO BEACH SUB.



DATED THIS 27th DAY OF APRIL 2011.



JOHN KROTT S - 2258 Wisconsin Registered Land Surveyor (original if signed in red)