
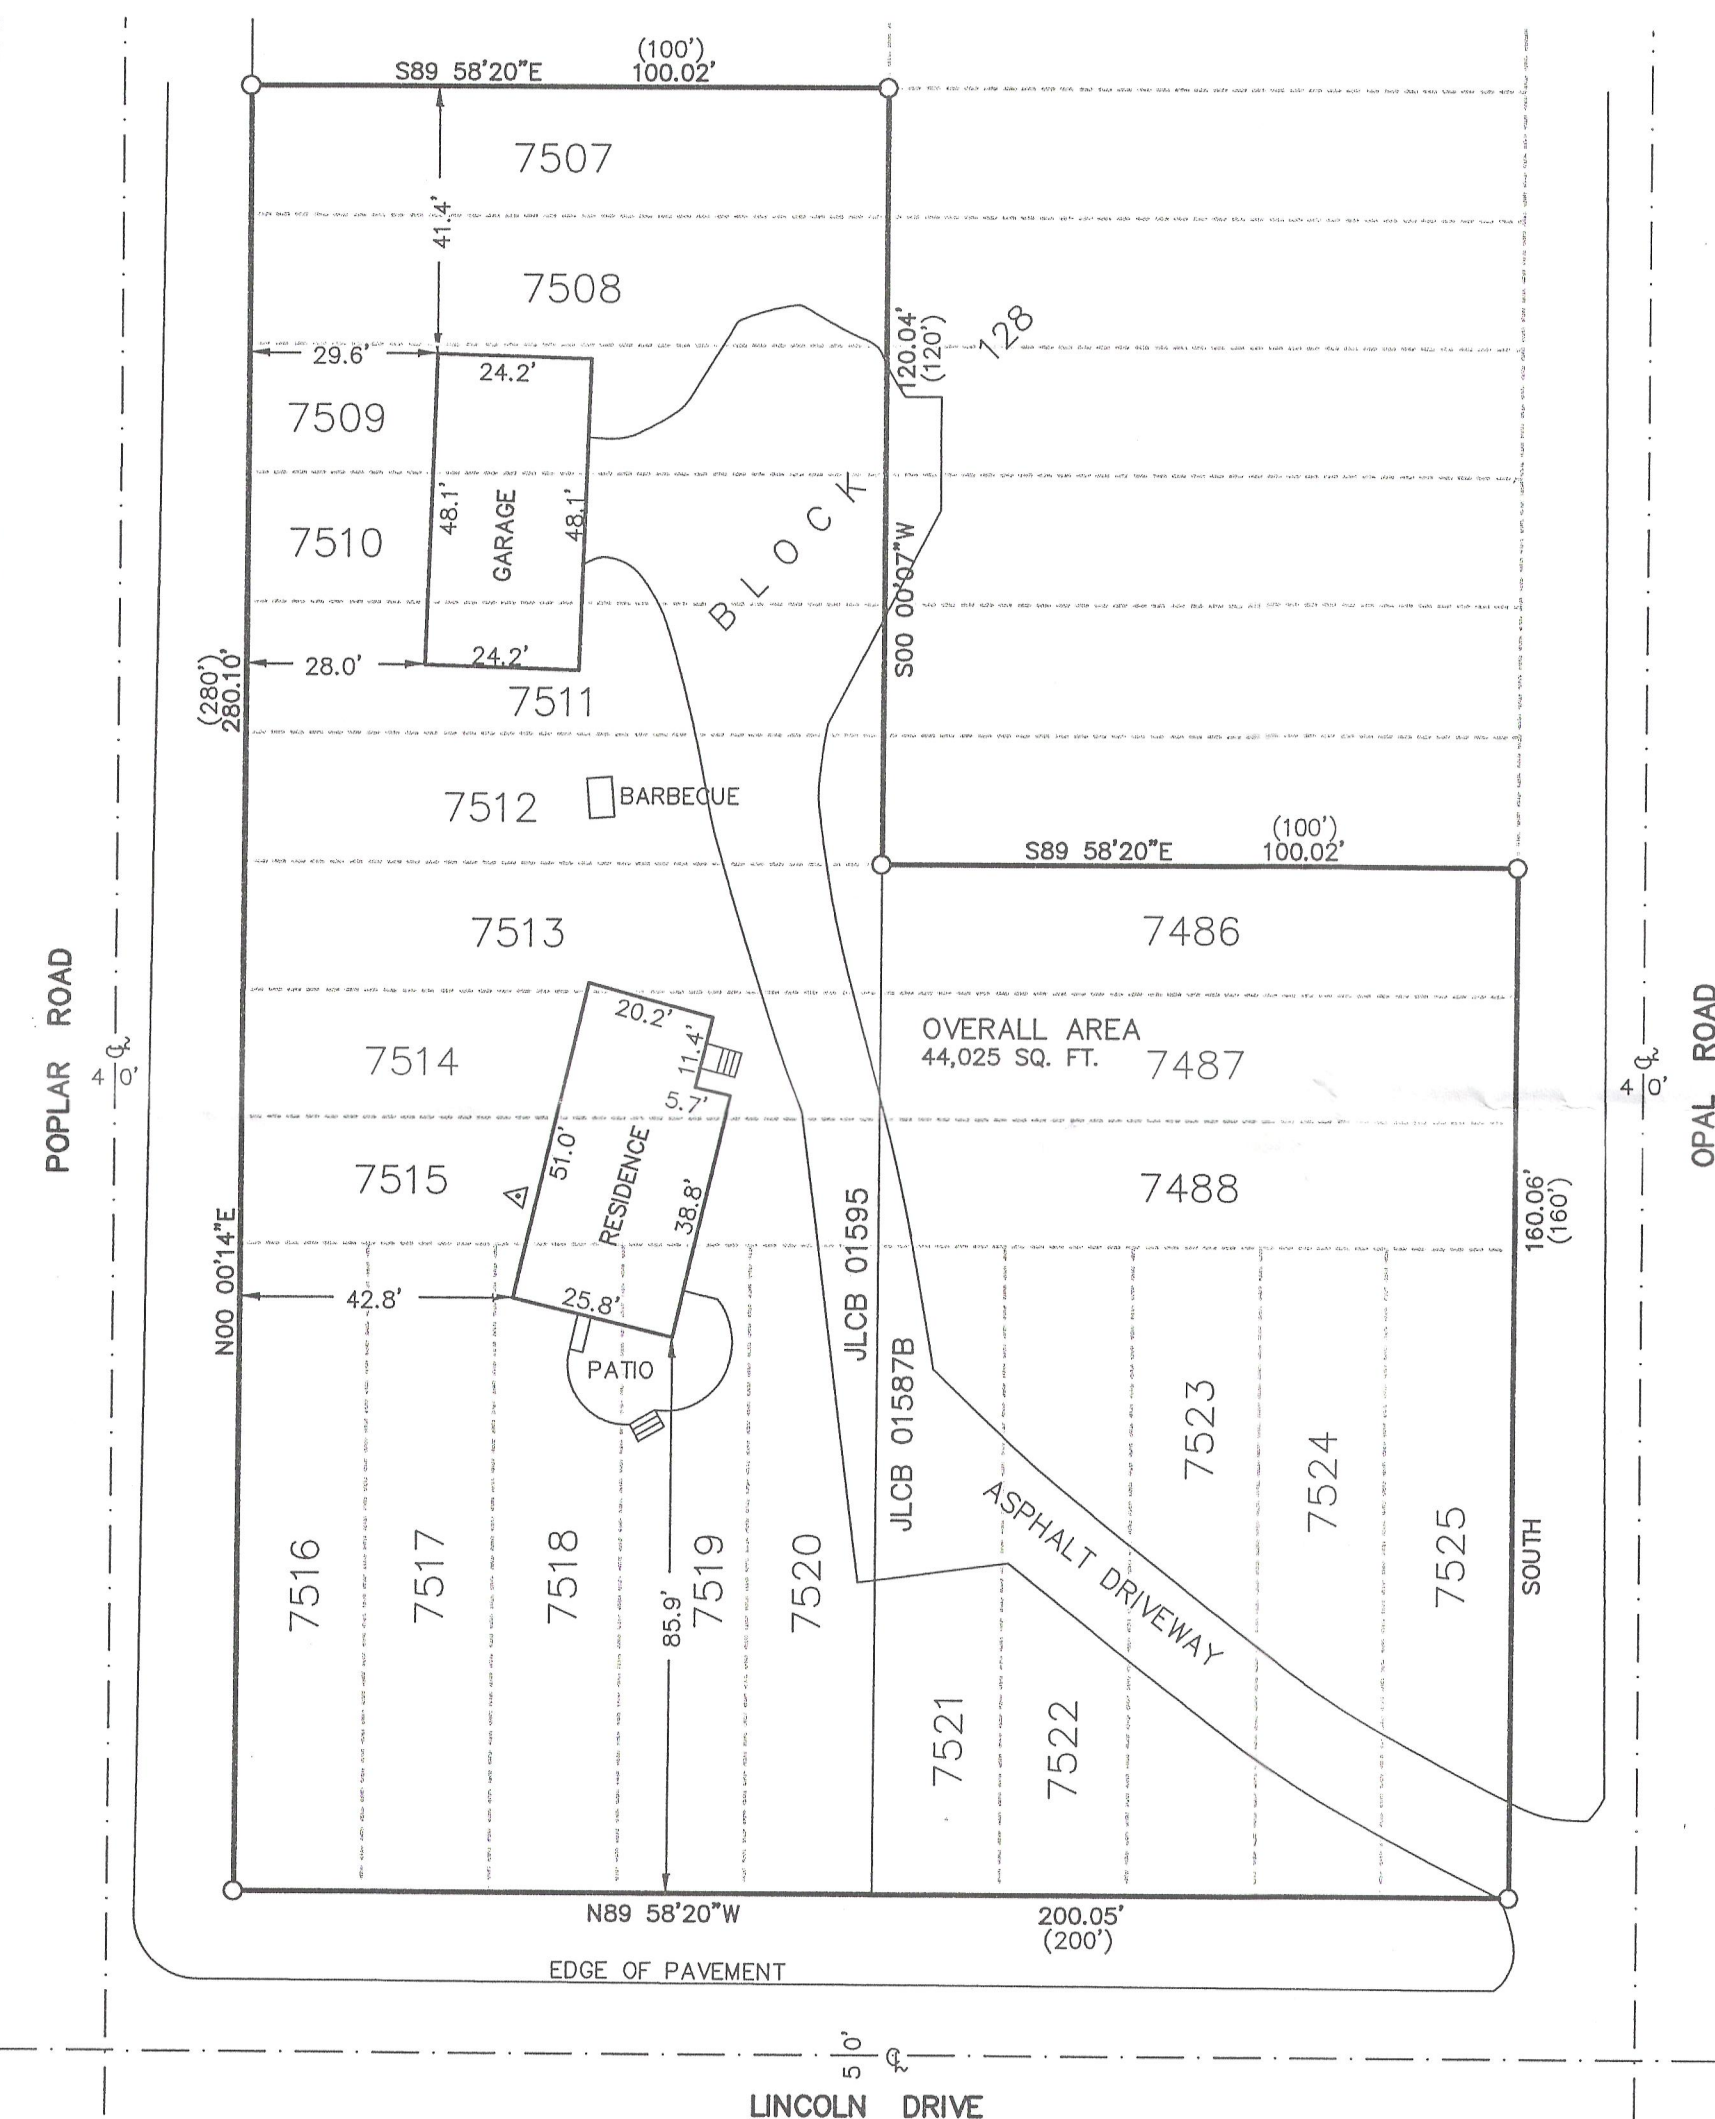


PLAT OF SURVEY

LOTS 7507 THRU 7525 & 7486 THRU 7488
BLOCK 128 LAKE COMO BEACH
A SUBDIVISION LOCATED IN THE NW 1/4 SECTION 28
TOWN 2 NORTH, RANGE 17 EAST
WALWORTH COUNTY, WI.

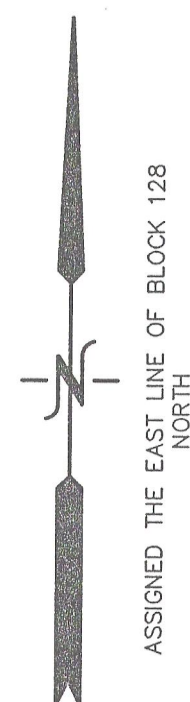



LEGEND
O = FOUND IRON PIPE STAKE
(XXX) = RECORDED AS

WORK ORDERED BY:
THOMAS MORAN
7338 N. OCTAVIA
CHICAGO, IL. 60631

FARRIS, HANSEN & ASSOCIATES, INC.
ENGINEERING - ARCHITECTURE - SURVEYING
7 RIDGWAY COURT P.O. BOX 437
ELKHORN, WISCONSIN 53121
OFFICE: (262) 723-2098 FAX: (262) 723-5886

REVISIONS

PROJECT NO.
8541
DATE:
03-22-2012
SHEET NO.
1 OF 1

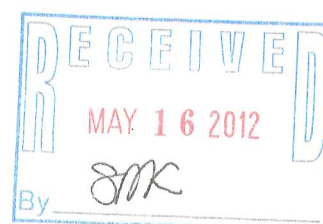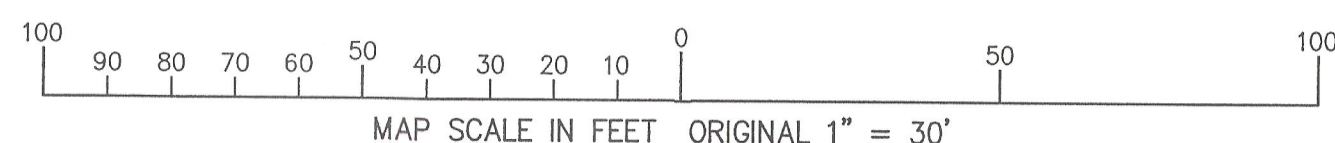

NOTE: COPIES OF THIS MAP TO WHICH THE FOLLOWING CERTIFICATE WILL APPLY SHOW THE SURVEYOR'S ORIGINAL SEAL AND SIGNATURE IN RED INK. COPIES BY ANY OTHER MEANS MAY HAVE ALTERATIONS WHICH DO NOT REPRESENT THE SURVEYOR'S WORK PRODUCT.

I HEREBY CERTIFY THAT THE ABOVE DESCRIBED PROPERTY HAS BEEN SURVEYED UNDER MY DIRECTION AND THAT THE ABOVE MAP IS A TRUE REPRESENTATION THEREOF AND SHOWS THE SIZE AND LOCATION OF THE PROPERTY AND ITS EXTERIOR BOUNDARIES. THIS SURVEY IS MADE FOR THE USE OF THE PRESENT OWNERS OF THE PROPERTY, AND ALSO THOSE WHO PURCHASE, MORTGAGE, OR GUARANTEE THE TITLE THERETO WITHIN ONE YEAR FROM THE DATE HEREOF.

DATED: MARCH 22, 2012

Peter S. Gordon
PETER S. GORDON R.L.S. 2101

3/22/2012 X:\Projects\8541\DCAD\SURVEY

JLCB-1595

217-3783