



PREPARED FOR  
THANKSGIVING PROPERTIES  
114 N MAIN ST  
WALWORTH WI.

# PLAT OF SURVEY

- OF -

LOTS 3831 THRU 3837 BLOCK 66 OF LAKE COMO BEACH SUBDIVISION;  
LOCATED IN TOWN 2 NORTH, RANGE 17 EAST, TOWN OF GENEVA,  
WALWORTH COUNTY, WISCONSIN

PATHFINDER SURVEYING INC.  
(formerly)  
J.K. SURVEYING INC.  
P.O BOX 322  
LAKE GENEVA, WI. 53147  
WWW.PATHFINDERSURVEYING.NET  
262-248-8303

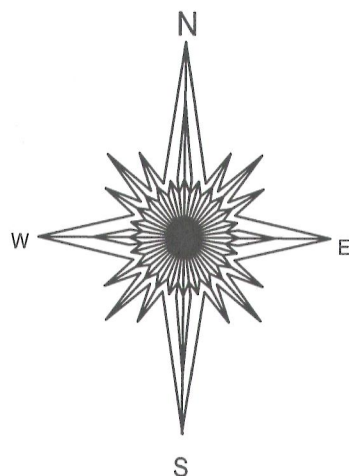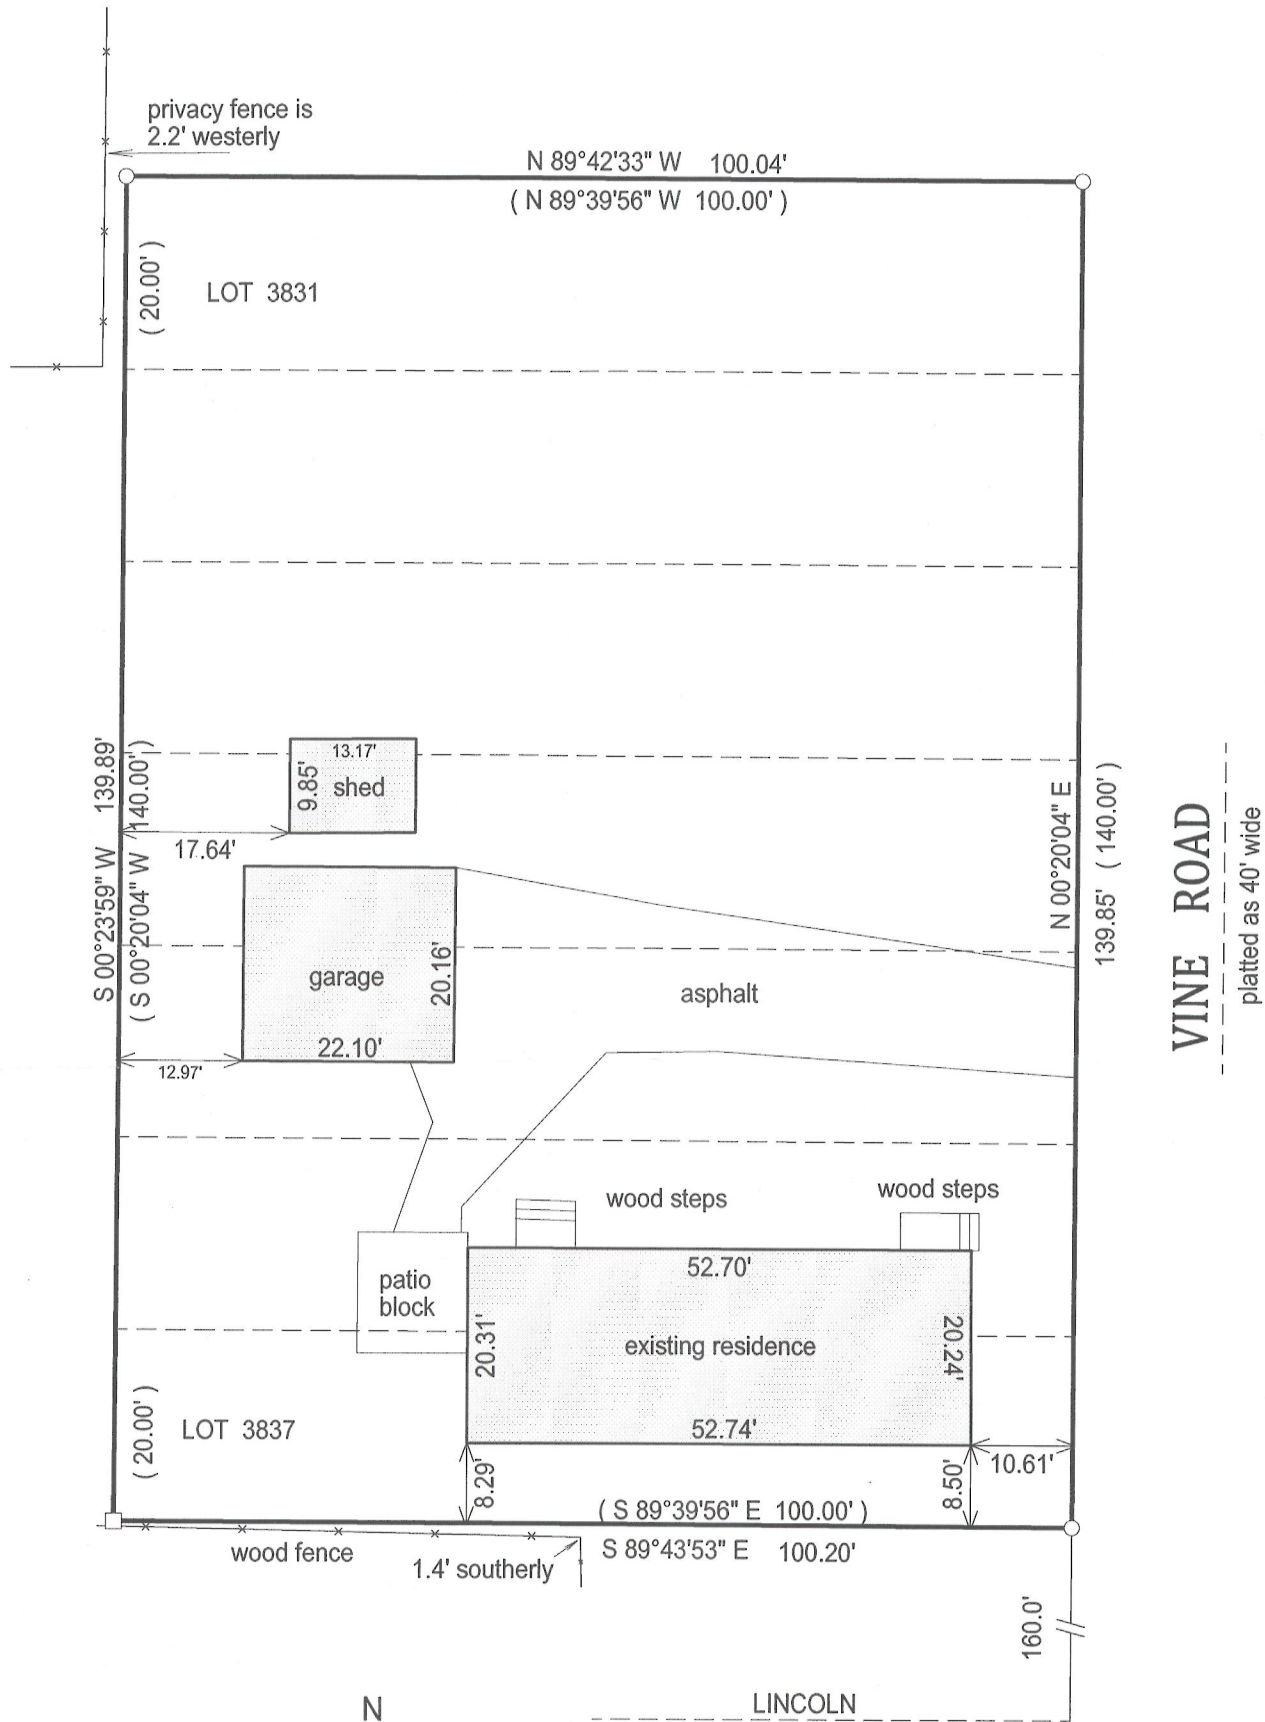

- ( ) = recorded as
- = found iron bar
- = found iron pipe
- = set iron pipe
- = set iron bar

SCALE 1" = 20'

JOB # 12-85

TAX ID #  
JLCB 00730

BASIS OF BEARING OF THIS PLAT: THE WEST LINE OF VINE ROAD  
WAS ASSUMED TO BEAR N0°20'04"E AS SHOWN ON THE RECORD PLAT.


"I hereby certify that I have surveyed the above described property and that the above map is a true representation of its exterior boundary and shows the size and location of all visible structures, apparent easements and encroachments if any."

This survey is made for the present owners of the property, and those who purchase, mortgage, or guarantee the title thereto, within one year from the date hereof.

DATED THIS 20TH DAY OF JUNE, 2012.



JEFFREY L. KIMPS S - 2436  
Wisconsin Registered Land Surveyor  
(original if signed in red)

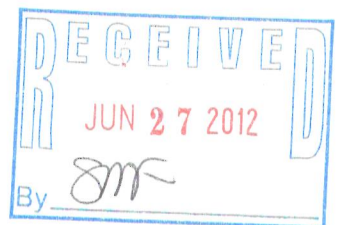

217-3789