




PREPARED FOR
BASSO BUILDERS
405 SKYLINE DR
LAKE GENEVA, WI 53147

KROTT SURVEYING INC.
N3705 WILLOW BEND LANE
LAKE GENEVA WI. 53147
PHONE # (262)248-3697
FAX # (262)249-0639

PLAT OF SURVEY

- OF -

LOTS 7773 THRU 7777 BLOCK 132 OF LAKE COMO BEACH SUBDIVISION;
LOCATED IN TOWN 2 NORTH, RANGE 17 EAST, WALWORTH COUNTY,
WISCONSIN

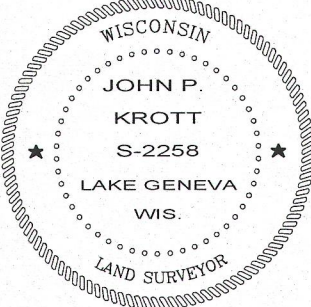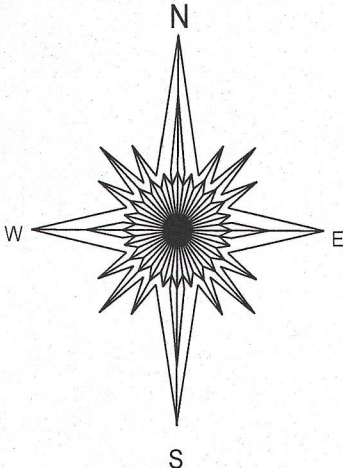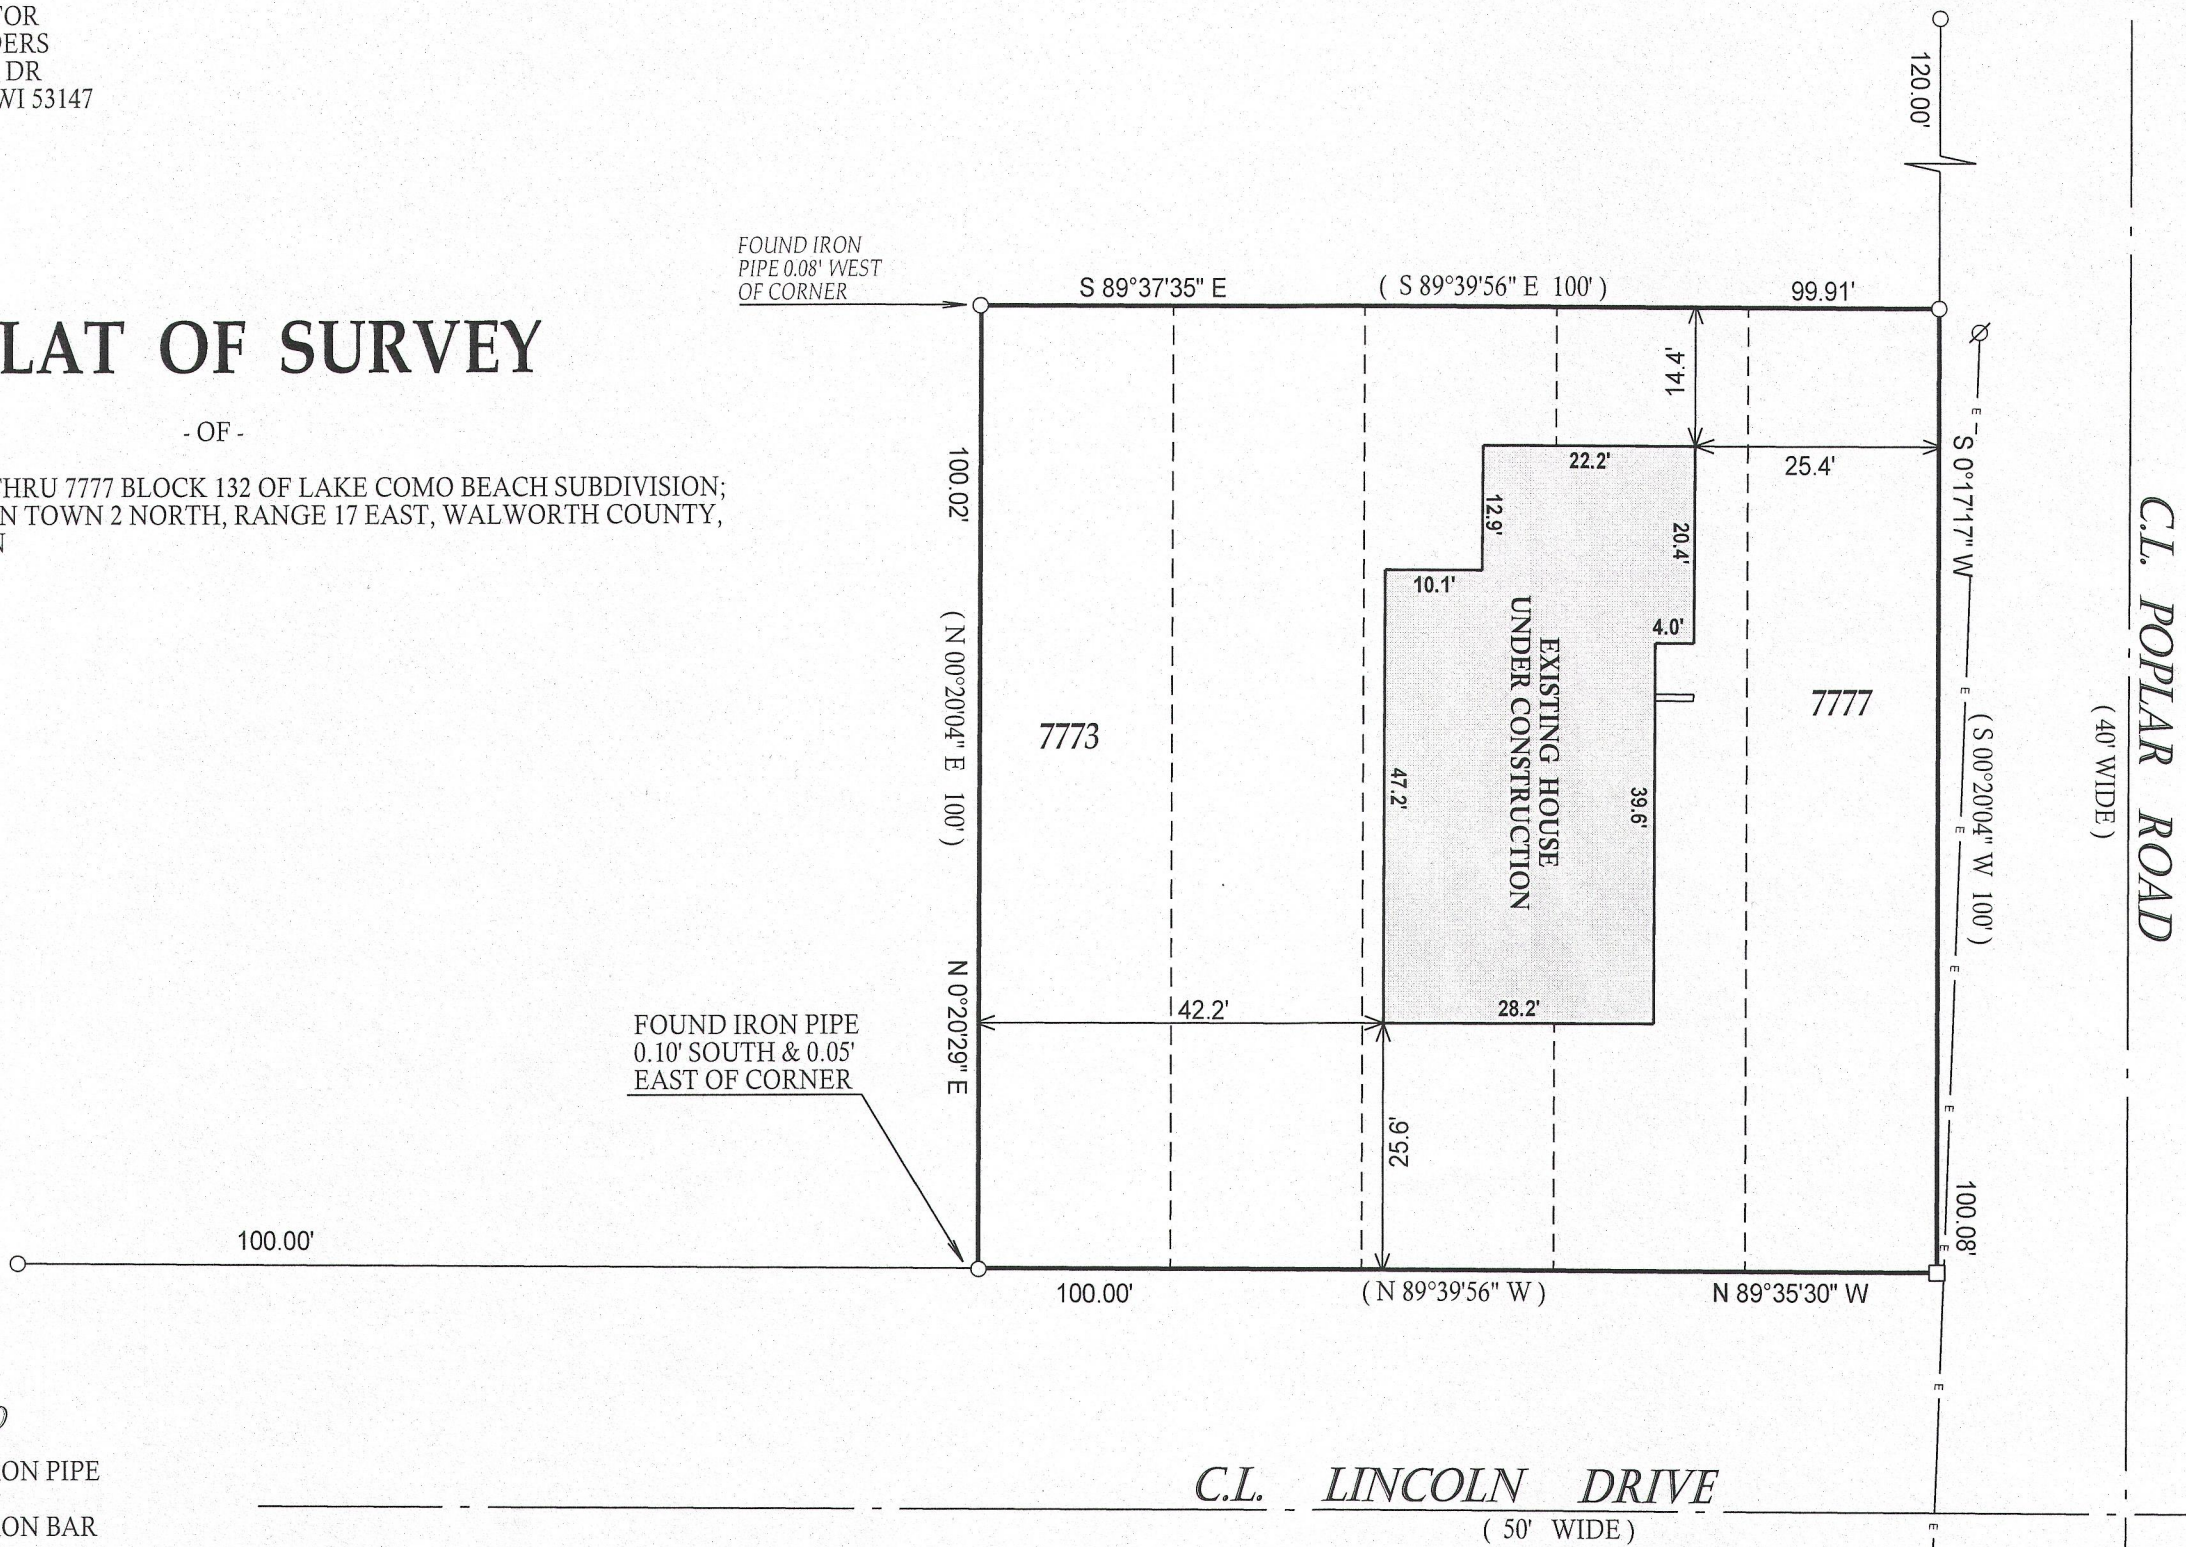

LEGEND


- FOUND IRON PIPE
- FOUND IRON BAR
- ⊗ UTILITY POLE
- E— OVERHEAD WIRES
- (xx) RECORDED AS

SCALE 1" = 20'
TAX ID # JLCB01653
JOB # 05-382SITE 2013

I have surveyed the above-described property and the above map is a true representation thereof and shows the size and location of the property, its exterior boundaries, the location and dimensions of all structures thereon, fences apparent easements and roadways and visible encroachments, if any.

This survey is made for the exclusive use of the present owners of the property, and also those who purchase, mortgage, or insure the title thereto within one (1) year from date hereof; and as to them I warrant the accuracy of said survey map.

DATED THIS 4th, DAY OF FEBRUARY, 2013
DATE OF LAST REVISION 05 / 15 / 2013

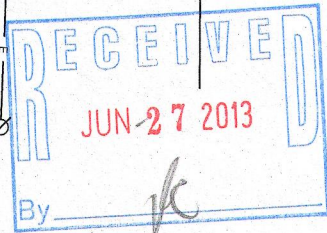

John P. Krott

JOHN KROTT S - 2258
Wisconsin Registered Land Surveyor
(original if signed in red)

217-3865