
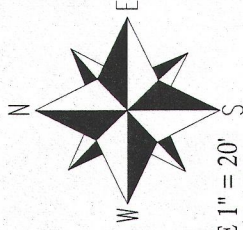


PREPARED FOR:
TORHORST LAW OFFICES LLC
500 COMMERCIAL COURT
LAKE GENEVA, WI 53147

PLAT OF SURVEY

KROTT SURVEYING INC.
N3705 WILLOW BEND LANE
LAKE GENEVA WI, 53147
PHONE # (262)248-3697
FAX # (262)249-0639

-OF-
LOTS 11559 THROUGH 11562, INCLUSIVE, ALL IN LAKE
COMO BEACH SUBDIVISION, IN THE TOWN OF GENEVA,
WALWORTH COUNTY, WISCONSIN, ACCORDING TO THE
PLAT THEREOF.

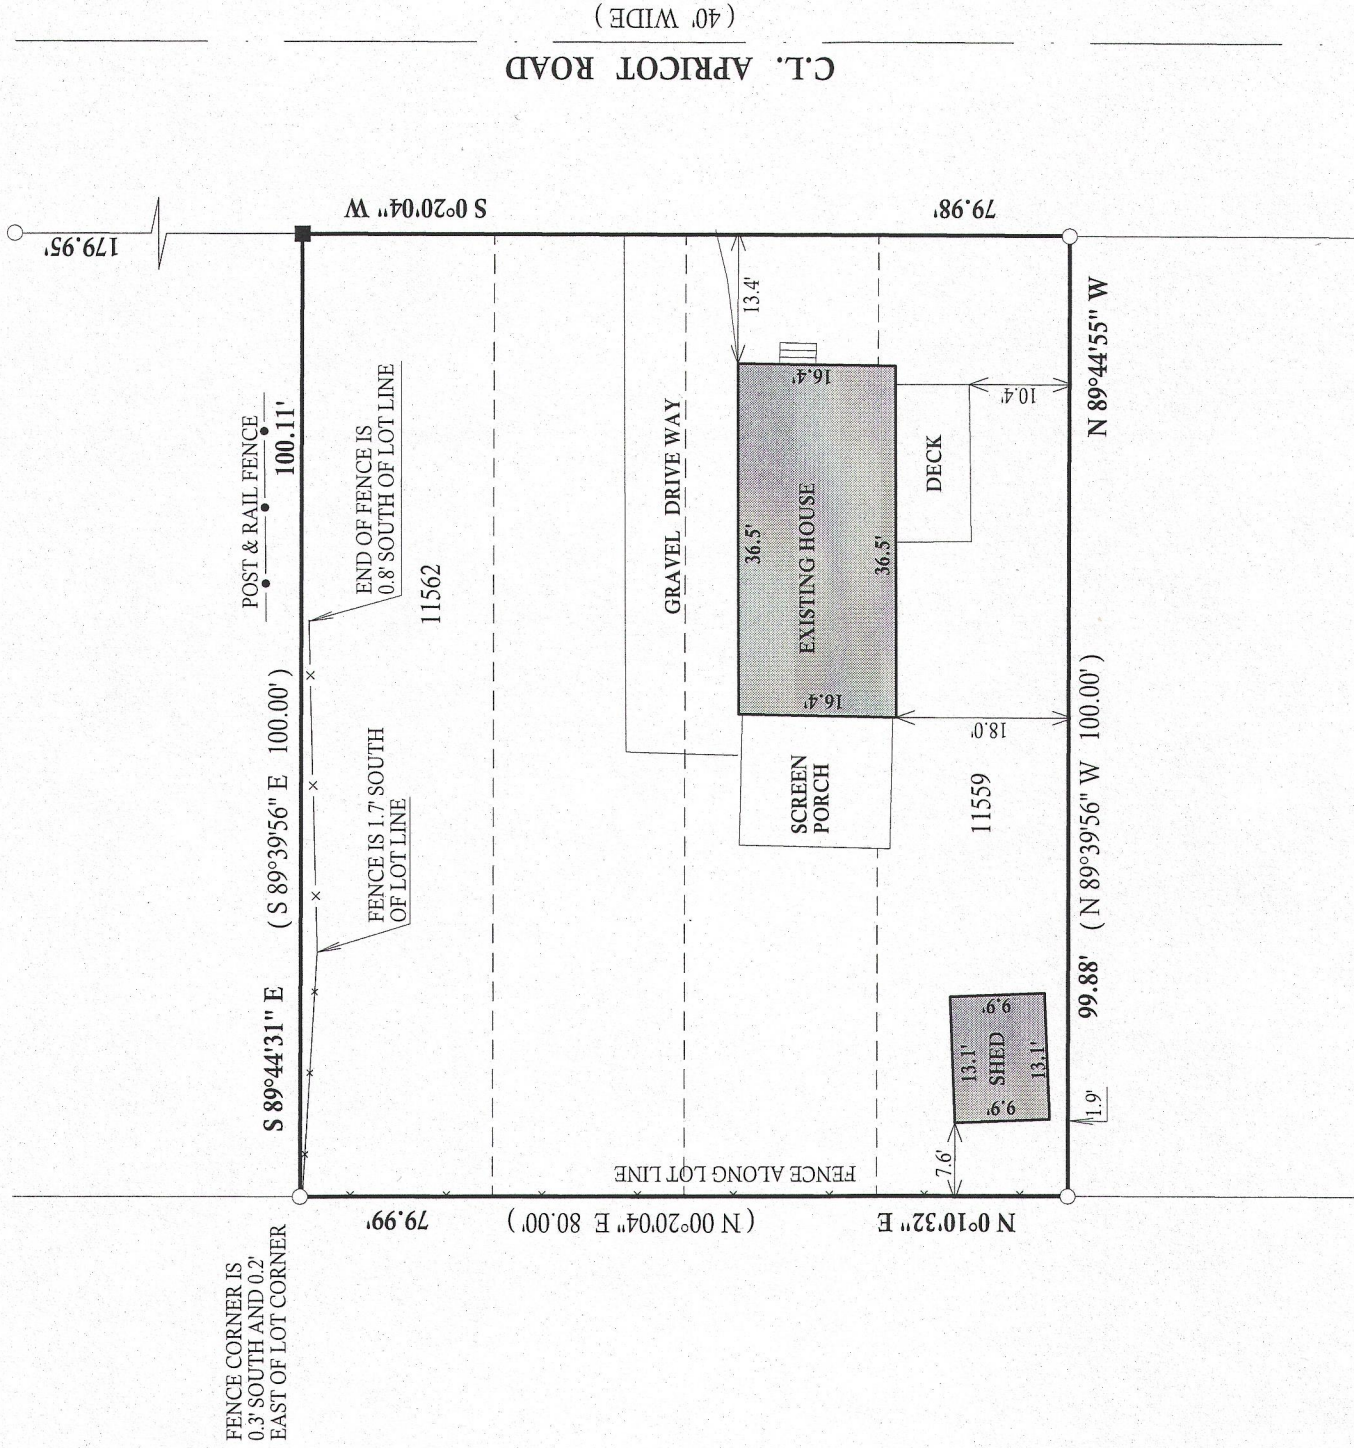

SCALE 1" = 20'
BEARINGS REFERENCED TO THE RECORD
PLAT OF LAKE COMO BEACH

LEGEND



- FOUND IRON PIPE
- FOUND IRON BAR
- SET IRON BAR

(XX) RECORDED AS

JOB #13-078 TAX ID # JLCB02509

I have surveyed the above-described property and the above map is a true representation thereof and shows the size and location of the property, its exterior boundaries, the location and dimensions of all structures thereon, fences apparent easements and roadways and visible encroachments, if any.

This survey is made for the exclusive use of the present owners of the property, and also those who purchase, mortgage, or insure the title thereto within one (1) year from date hereof; and as to them I warrant the accuracy of said survey map.

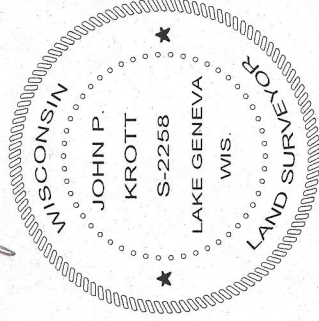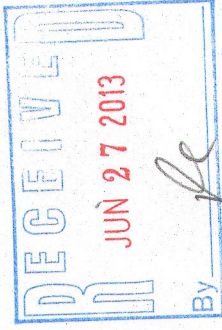

DATED THIS 4th, DAY OF JUNE, 2013

John P. Krott

JOHN KROTT S - 2258
Wisconsin Registered Land Surveyor
(original if signed in red)

217-3866