



PREPARED FOR
RYAN CUTTS
JAMIE LAGRECA
N3175 WILLOW RD
LAKE GENEVA, WI. 53147

PLAT OF SURVEY

PATHFINDER SURVEYING INC.
(formerly)
J.K. SURVEYING INC.
P.O BOX 322
LAKE GENEVA, WI. 53147
WWW.PATHFINDERSURVEYING.NET
262-248-8303

- OF -

LOTS 11505 THRU 11509 BLOCK 207 OF LAKE COMO BEACH SUBDIVISION;
LOCATED IN TOWN 2 NORTH, RANGE 17 EAST, WALWORTH COUNTY,
WISCONSIN

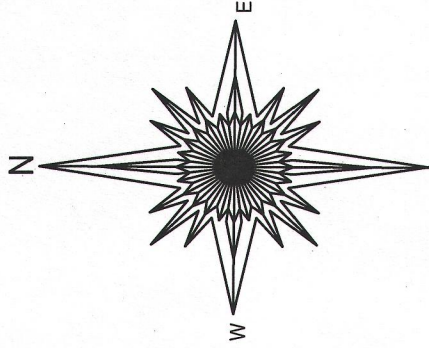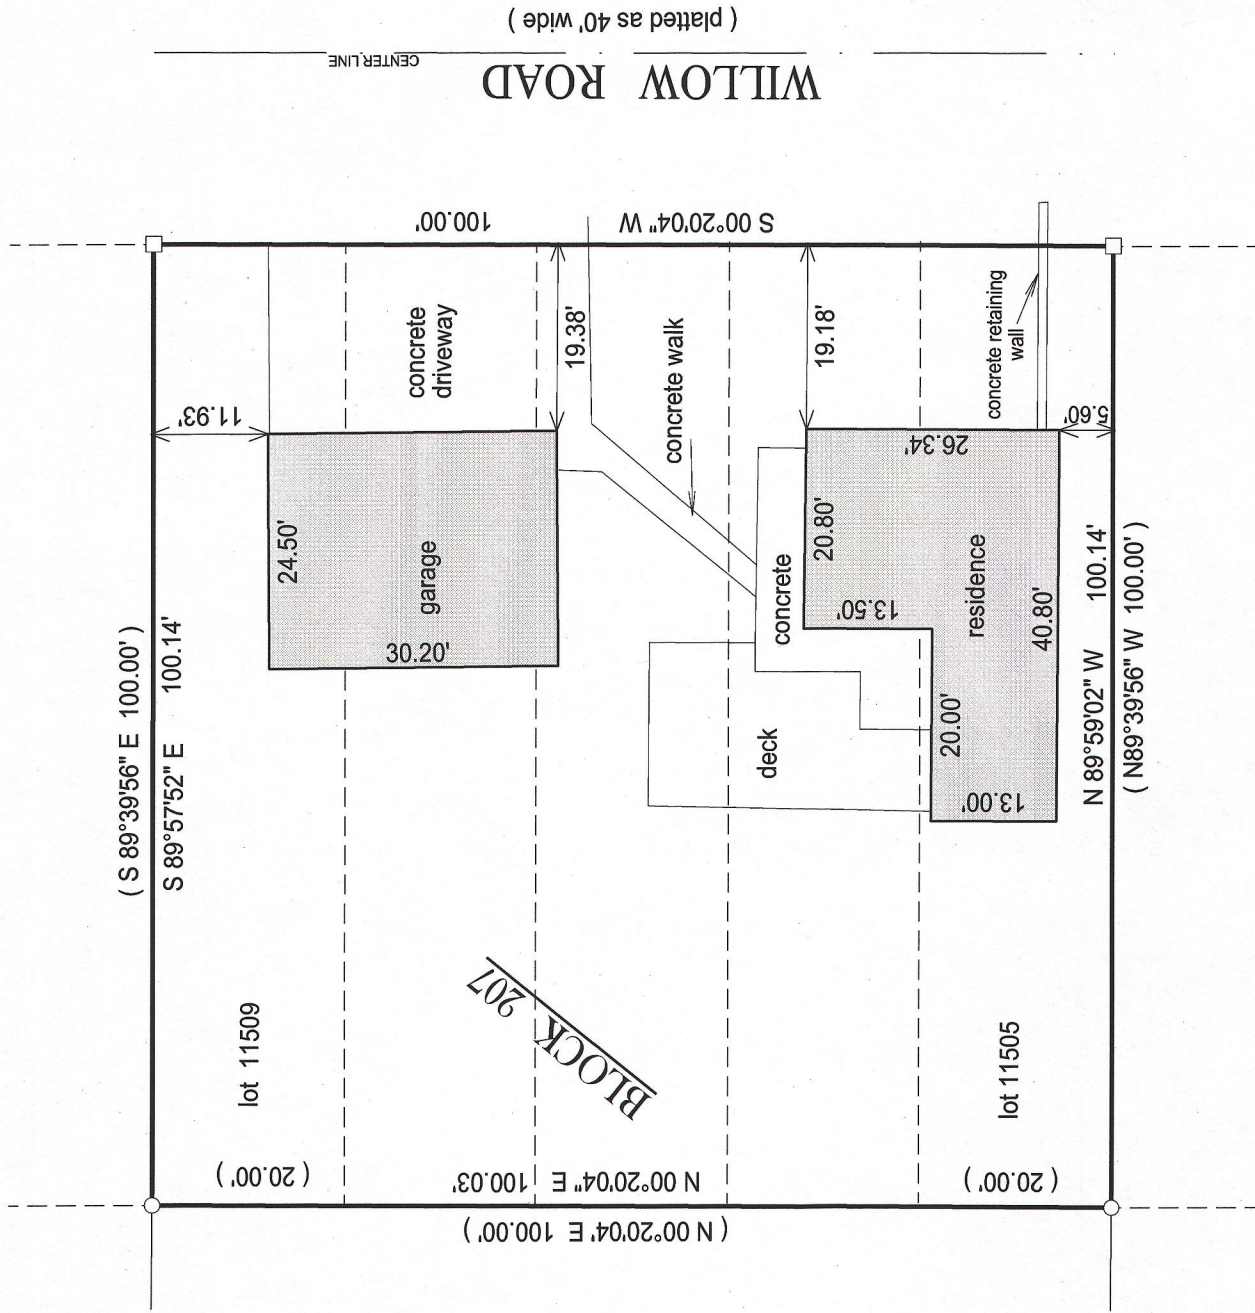

BASIS OF BEARING OF THIS PLAT: THE WEST LINE OF WILLOW RD. WAS
ASSUMED TO BE S00°20'04" W AS SHOWN ON THE RECORD PLAT OF
LAKE COMO BEACH.


I hereby certify that I have surveyed the above-described property and the
above map is a true representation thereof and shows the size and
location of the property, its exterior boundaries, the location and
dimensions of all structures thereon, fences, apparent easements and
roadways and visible encroachments if any.

This survey is made for the present owners of the property, and those who
purchase, mortgage, or guarantee the title thereto, within one year from
the date hereof.

JOB # 13-74

TAX ID #
JLCB 02500

DATED THIS 1ST DAY OF JUNE, 2013.

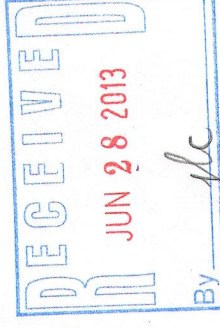

JEFFREY L. KIMPS S - 2436
Wisconsin Registered Land Surveyor
(original if signed in red)

217-3875