


PREPARED FOR
DAVID RASMUSSEN
113 KENOSHA ST.
WALWORTH WI. 53184

PLAT OF SURVEY

-OF-


KROTT SURVEYING INC.
N3705 WILLOW BEND LANE
LAKE GENEVA WI. 53147
PHONE # (262)248-3697
FAX # (262)249-0639

LOTS 7832 THRU 7836 BLOCK 133 OF LAKE COMO BEACH SUBDIVISION
TOWN 2 NORTH, RANGE 17 EAST, WALWORTH COUNTY, WISCONSIN.

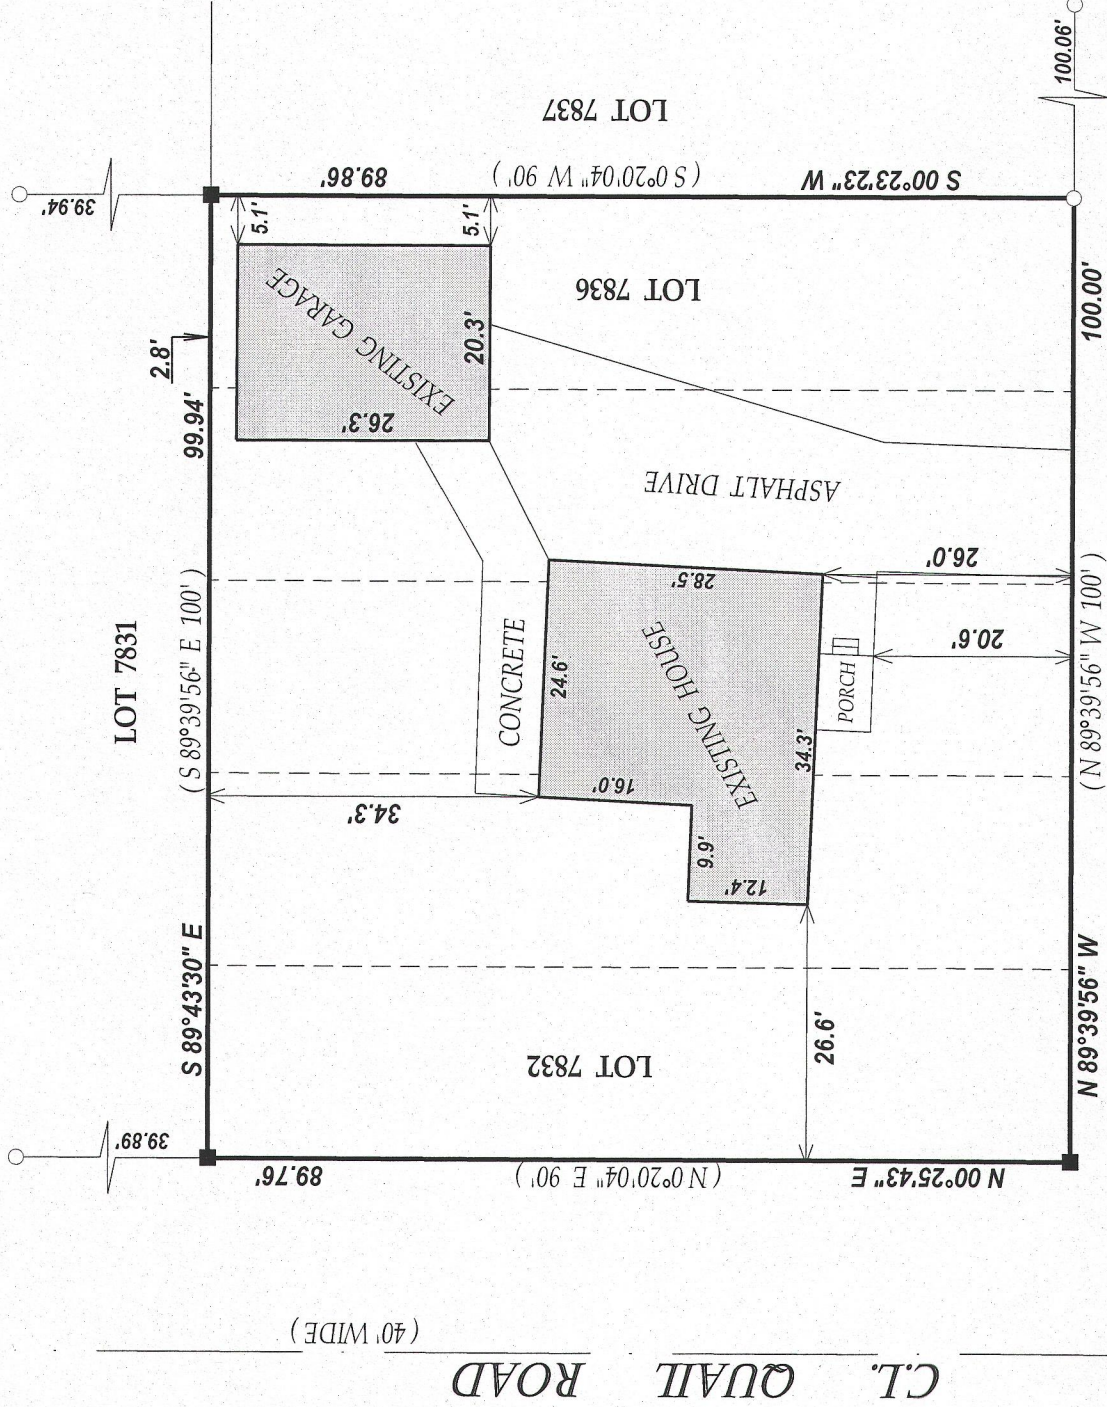

C.L. LONGFELLOW DRIVE

(40' WIDE)

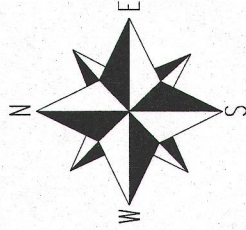

SCALE 1" = 20'



NOTE: BEARINGS ARE REFERENCED TO THE RECORD PLAT

I have surveyed the above-described property and the above map is a true representation thereof and shows the size and location of the property, its exterior boundaries, the location and dimensions of all structures thereon, fences apparent easements and roadways and visible encroachments, if any.

This survey is made for the exclusive use of the present owners of the property, and also those who purchase, mortgage, or insure the title thereto within one (1) year from date hereof; and as to them I warrant the accuracy of said survey map.


LEGEND

- FOUND IRON PIPE
- SET IRON BAR

(XX) RECORDED AS

TAX ID # JLCB01667

JOB # 13-008

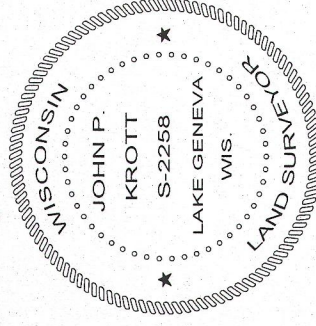

DATED THIS 28th DAY OF JANUARY 2013

John P. Krott

JOHN KROTT S - 2258
Wisconsin Registered Land Surveyor
(original if signed in red)

217 - 3877