

PREPARED FOR:
LAKE GENEVA AREA REALTY
101 BROAD ST
LAKE GENEVA, WI.


PLAT OF SURVEY

PATHFINDER SURVEYING INC.
(formerly)
J.K. SURVEYING INC.
P.O BOX 322
LAKE GENEVA, WI. 53147
WWW.PATHFINDERSURVEYING.NET
262-248-8303

LOTS 8676, 8677 AND 8683-8687, BLOCK 149 OF LAKE COMO BEACH
SUBDIVISION, LOCATED IN TOWN 2 NORTH, RANGE 17 EAST, WALWORTH
COUNTY, WISCONSIN. EXCEPTING THEREFROM THE WEST 4.00 FEET OF LOTS
8676, 8677 AND 8687, OF SAID BLOCK 149.

(W3719 SPRINGFIELD ROAD)

SPRINGFIELD ROAD / PALMER ROAD

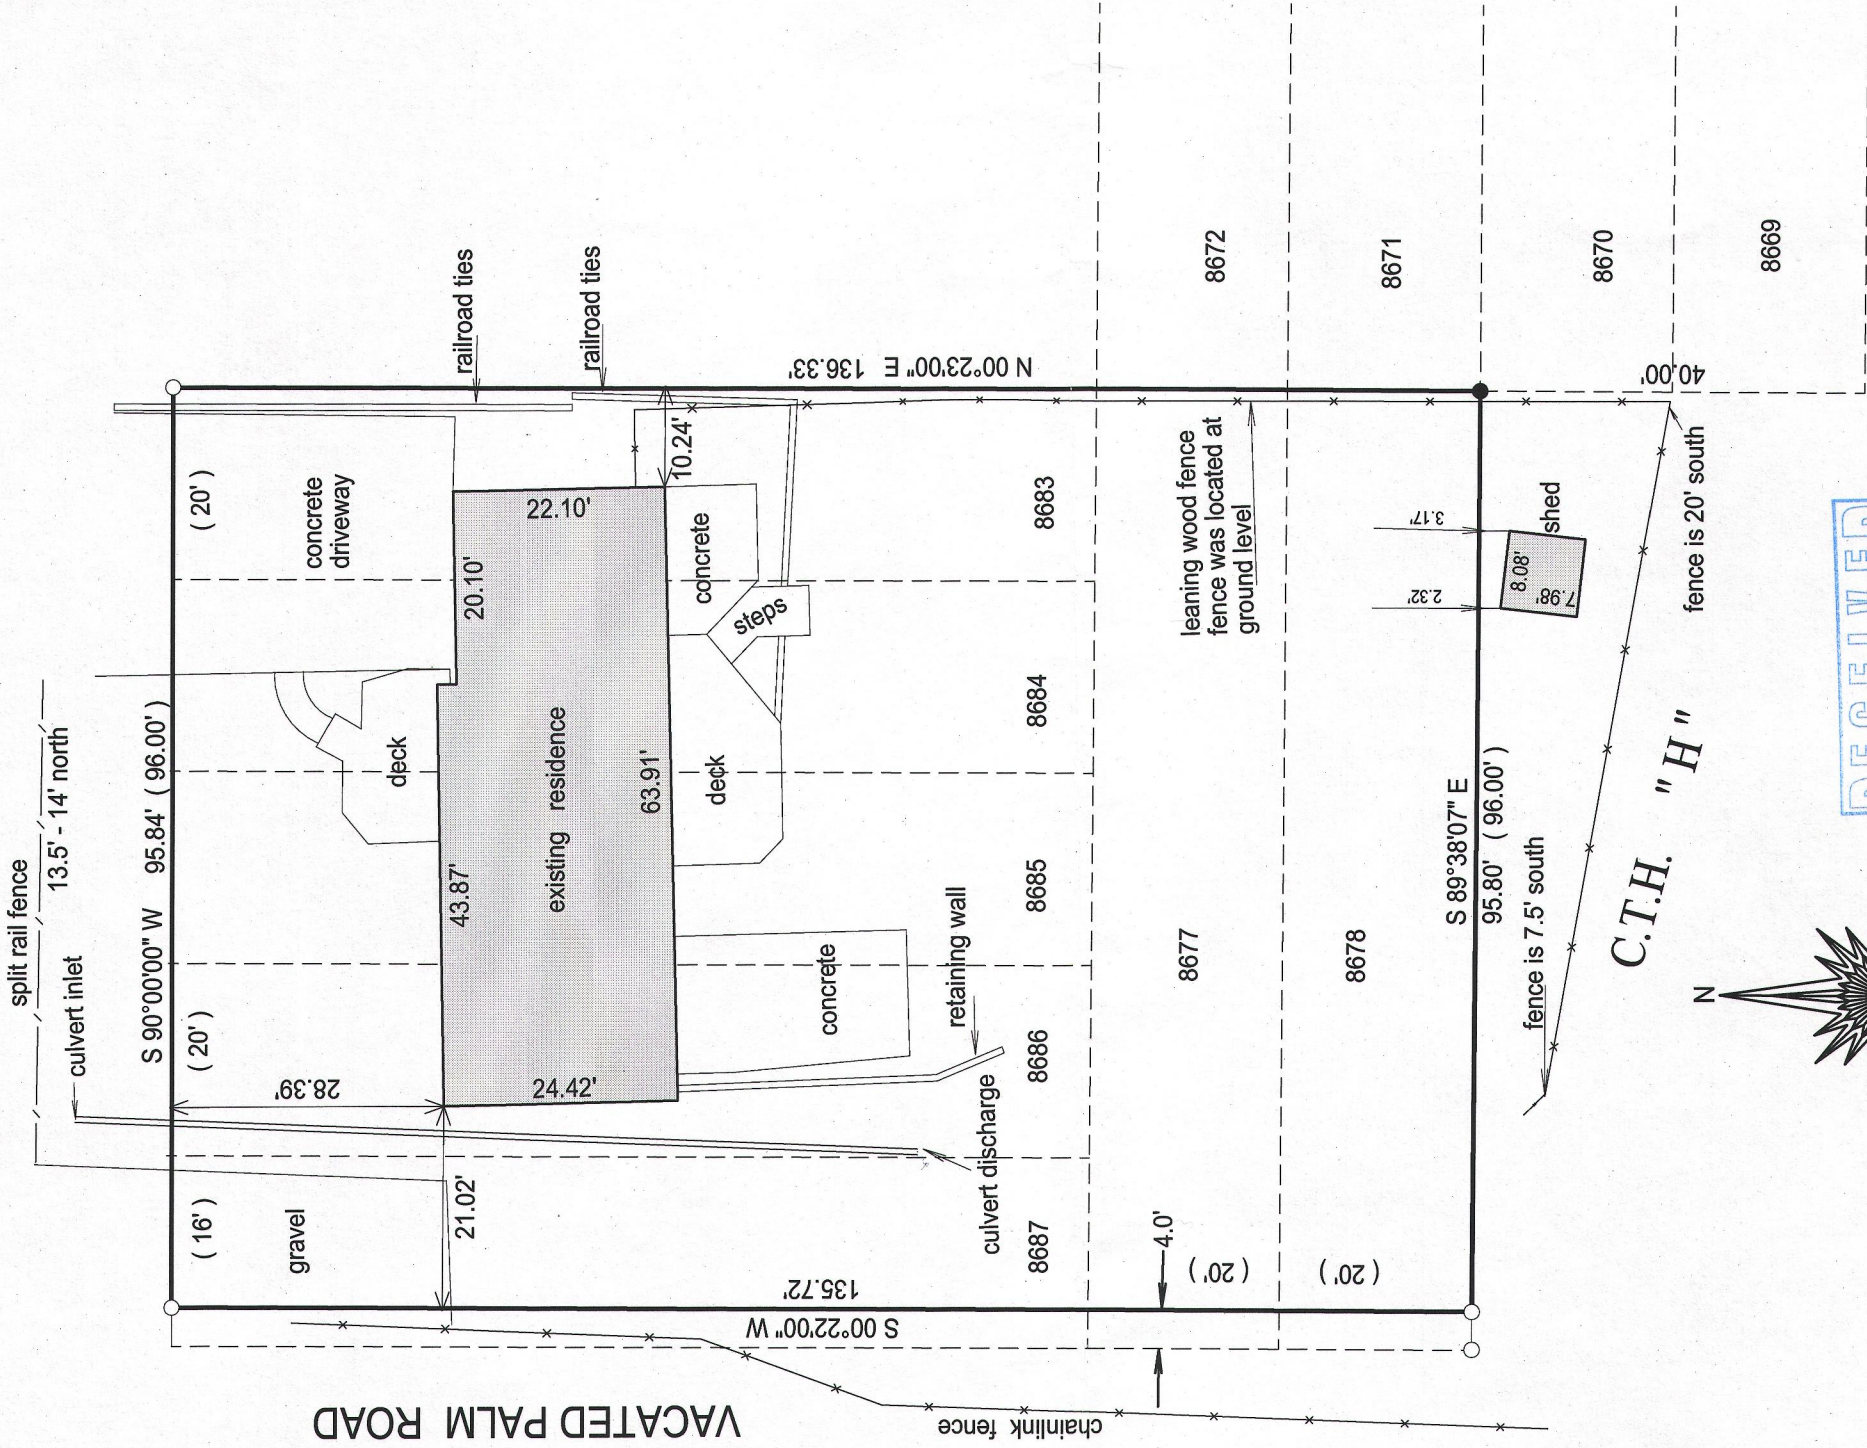

- () = recorded as
- = found iron bar
- = found iron pipe
- = set iron pipe
- = set iron bar

SCALE 1" = 20'

JOB # 13-27

TAX ID #

JLCB 01858 & 01855

BASIS OF BEARING OF THIS PLAT: THE SOUTH LINE OF PALMER/
SPRINGFIELD ROAD WAS ASSUMED TO BEAR EAST / WEST.

I hereby certify that I have surveyed the above- described property and the
above map is a true representation thereof and shows the size and
location of the property, its exterior boundaries, the location and
dimensions of all structures thereon, fences, appurtenant easements and
roadways and visible encroachments if any.

This survey is made for the present owners of the property, and those who
purchase, mortgage, or guarantee the title thereto, within one year from
the date hereof.

DATED THIS 1ST DAY OF APRIL, 2013



Jeffrey L. Kimps
JEFFREY/L KIMPS S - 2436
Wisconsin Registered Land Surveyor
(original if signed in red)

JLCB 01858
JLCB 01855

217-3880