

PLAT OF SURVEY

OF

Block 25

LOT 14

LOT 15

LOT 16

LOT 17

HOLDING TANK

PARK DRIVE

existing edge of pavement

LOT 14
 (N 89°56' W 115.00')
 N 89°34'28" W 115.46'

LOT 15
 (50.00')


LOT 16
 (50.00')

LOT 17
 S 89°34'01" E 115.33'
 (S 89°56' E 115.00')

HOLDING TANK
 N 79°37'44" E 5.87'

PARK DRIVE
 N 00°00'00" W 99.88' (100.00')

existing edge of pavement
 S 00°04'30" E 99.86'
 (SOUTH 100.00')

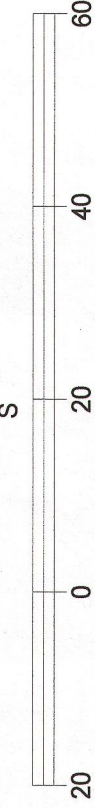

DATED THIS 11TH DAY OF SEPTEMBER, 2013.

~~JEFFREY L KIMPS S - 2436~~
Wisconsin Registered Land Surveyor
(original if signed in red)

217-3904