

PREPARED FOR
BASSO BUILDERS
405 SKYLINE DR.
LAKE GENEVA WI. 53147

PLAT OF SURVEY



-OF-

LOTS 4061 THRU 4065 BLOCK 70 LAKE COMO BEACH
SUBDIVISION LOCATED IN TOWN 2 NORTH, RANGE 17
EAST, WALWORTH COUNTY, WISCONSIN.

KROTT SURVEYING INC.
N3705 WILLOW BEND LANE
LAKE GENEVA WI. 53147
PHONE # (262)248-3697
FAX # (262)249-0639

C.L. LAKEVIEW DRIVE
(50' WIDE) PLATTED AS LINCOLN DRIVE

EDGE OF ASPHALT ROADWAY

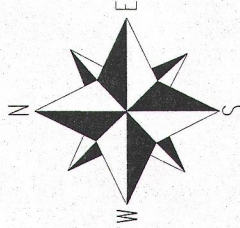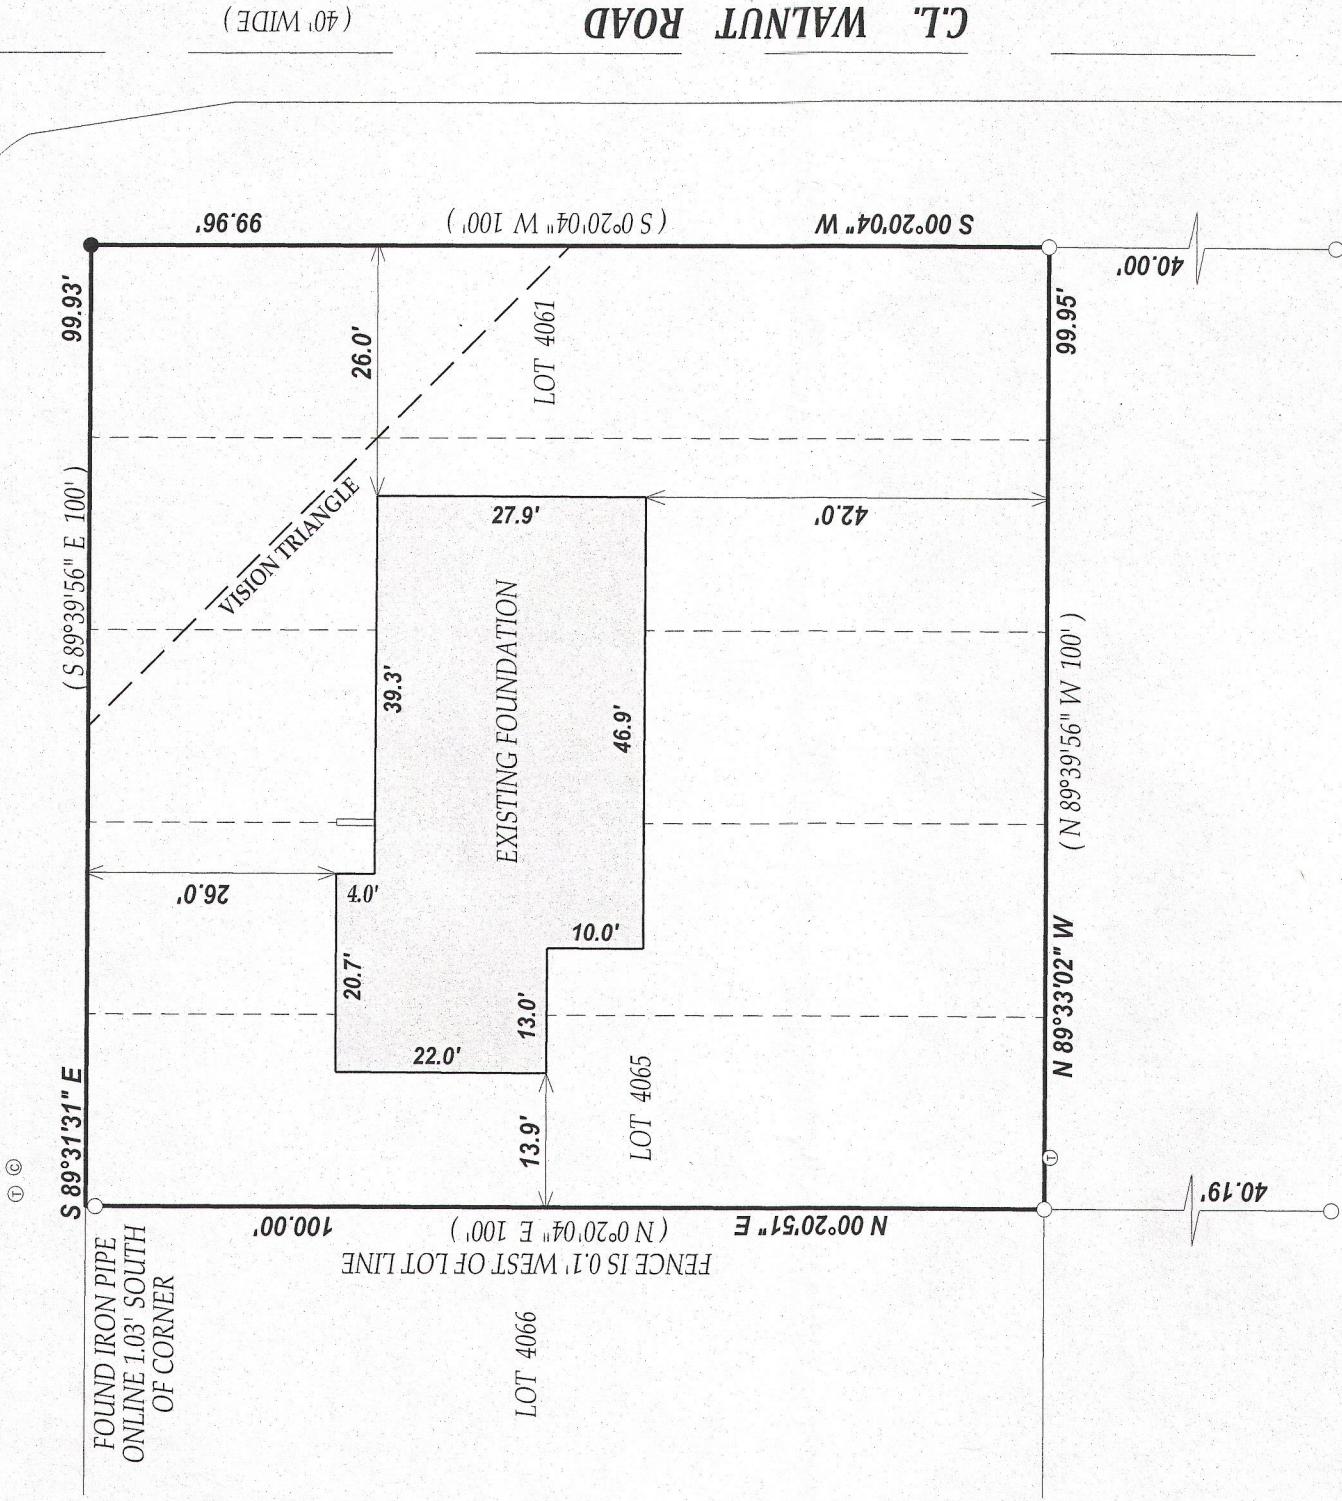

SCALE 1" = 20'



NOTE: BEARINGS ARE REFERENCED TO THE RECORD PLAT
NOTE: VERTICAL DATUM BASED ON N.G.V.D. 1929

LEGEND

- FOUND IRON PIPE
- SET IRON PIPE
- ⊕ TELEPHONE PEDESTAL
- ⊙ CABLE PEDESTAL

(XX) RECORDED AS


TAX ID # ILCB00780

JOB # 13-084AB


I have surveyed the above-described property and the above map is a true representation thereof and shows the size and location of the property, its exterior boundaries, the location and dimensions of all structures thereon, fences apparent easements and roadways and visible encroachments, if any.

This survey is made for the exclusive use of the present owners of the property, and also those who purchase, mortgage, or insure the title thereto within one (1) year from date hereof; and as to them I warrant the accuracy of said survey map.

DATE OF LAST REVISION: 9/13/2013
DATED THIS 17th DAY OF JUNE 2013

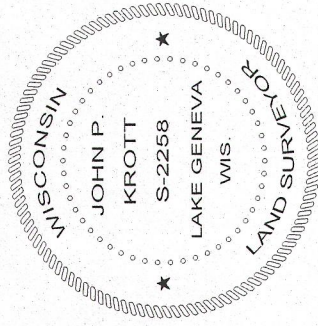

JOHN KROTT S-2258
Wisconsin Registered Land Surveyor
(original if signed in red)

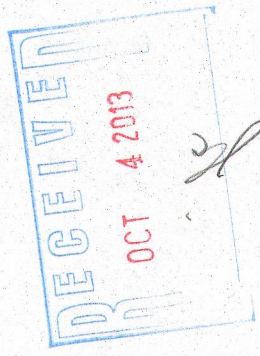

217-3912