

PREPARED FOR
DIANE COCROFT
KEEFE REAL ESTATE, INC.
751 GENEVA PARKWAY
LAKE GENEVA, WI 53147

PLAT OF SURVEY

-OF-

KROTT SURVEYING INC.
N3705 WILLOW BEND LANE
LAKE GENEVA WI. 53147
PHONE # (262)248-3697
FAX # (262)249-0639



LOTS 6816, 6817, 6818, 6819, 6820 BLOCK ONE HUNDRED SEVENTEEN (117)
IN LAKE COMO BEACH SUBDIVISION, IN THE TOWN OF GENEVA,
COUNTY OF WALWORTH, AND STATE OF WISCONSIN. ALSO LOTS
6852 AND 6853 BLOCK ONE HUNDRED SEVENTEEN (117) OF LAKE
COMO BEACH, TOWN OF GENEVA, WALWORTH COUNTY, WISCONSIN.

C.L. LINCOLN DRIVE

(50' WIDE)

C.L. MISTLE ROAD

(40' WIDE)

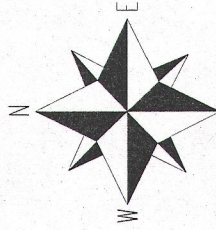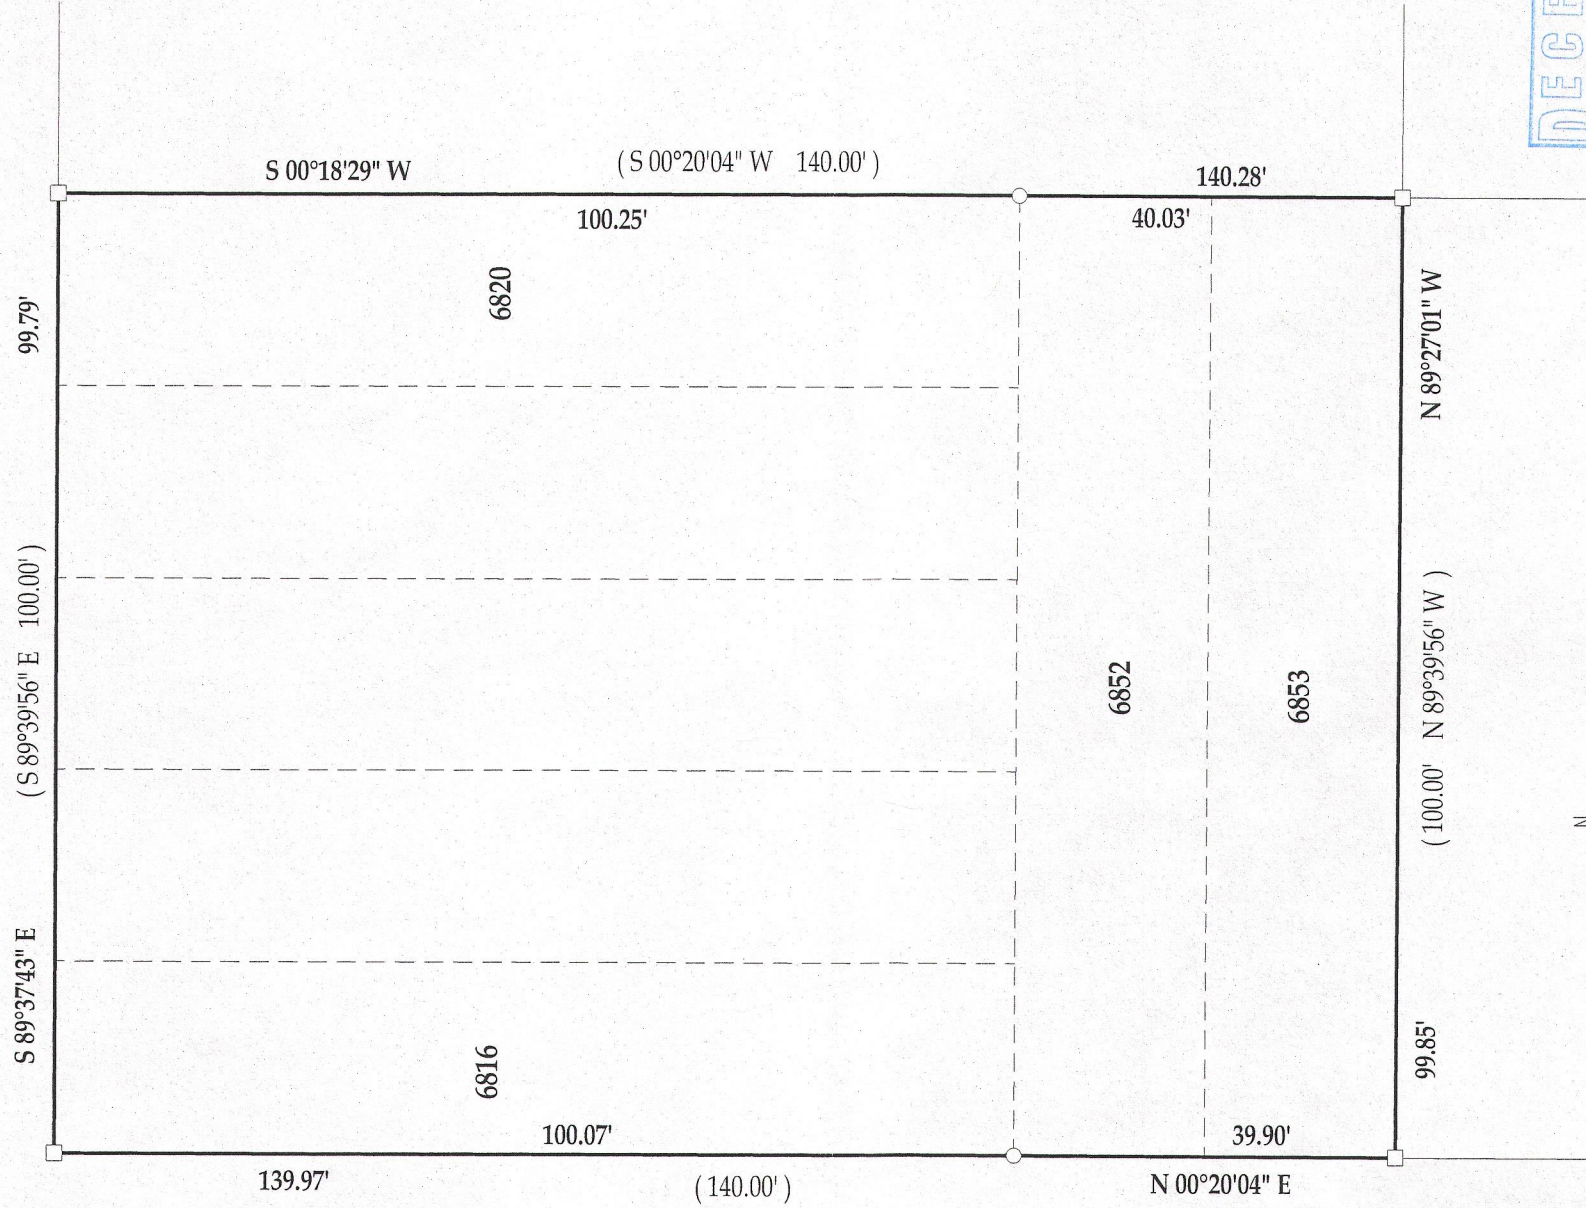

SCALE 1" = 20' S

BEARINGS REFERENCED TO THE RECORD PLAT
OF LAKE COMO BEACH

LEGEND

- FOUND IRON PIPE
- FOUND IRON BAR
- SET IRON BAR


(XX) RECORDED AS

JOB # 13-145 TAX ID # JLCB01432

I have surveyed the above-described property and the above map is a true representation thereof and shows the size and location of the property, its exterior boundaries, the location and dimensions of all structures thereon, fences apparent easements and roadways and visible encroachments, if any.

This survey is made for the exclusive use of the present owners of the property, and also those who purchase, mortgage, or insure the title thereto within one (1) year from date hereof; and as to them I warrant the accuracy of said survey map.

DATED THIS 24th, DAY OF SEPTEMBER, 2013

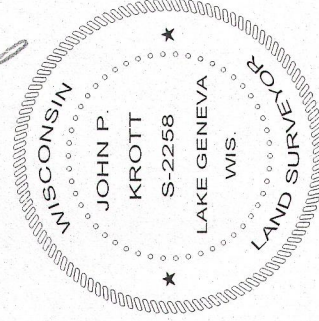

JOHN KROTT S - 2258
Wisconsin Registered Land Surveyor
(original if signed in red)

217-3914