


OF

NE 602
BK 102

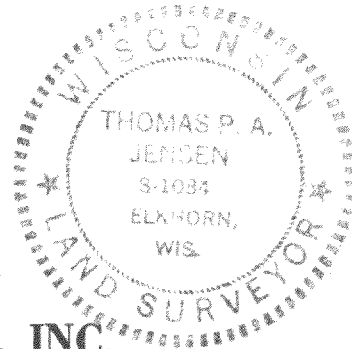

JENSEN & JOHNSON, INC.
CIVIL ENGINEERS AND SURVEYORS

○ — Iron Pipe *SET*
● — Concrete Monument.

Scale 1" = 30'

Ø - IRON PIPE FOUND

WE CERTIFY: That we have surveyed the above described property and that the plat shown hereon is an accurate survey and a true representation thereof and correctly shows the exterior boundary lines and all divisions of said property, *AND ALL BUILDINGS THEREON.*

Date MAY 12, 1974

Wisconsin Registered Land Surveyor, No. S-~~1000~~