
PREPARED FOR MIKE LINDSEY W3896 CLEARVIEW DRIVE LAKE GENEVA WI. 53147

PLAT OF SURVEY OF

LOTS 1, 2, 3 AND 13 IN BLOCK 21 OF SUNSET HILLS SUBDIVSION, UNIT B, SITUATED IN SECTION 33, TOWN 2 NORTH, RANGE 17 EAST, WALWORTH COUNTY, WISCONSIN

SUNSET

(NORTH ROADWAY) (50' WIDE

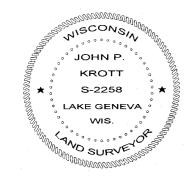

DATED THIS 15th DAY OF OCTOBER 2013

JOHN P. KROTT S-2258
WISCONSIN REGISTERED LAND SURVEYOR
(NOTE: THIS IS NOT A CERTIFIED COPY
UNLESS SIGNED IN RED INK)

LEGEND


- O FOUND IRON PIPE
- ⊕ CONCRETE ACCESS COVER
- **#** METAL ACCESS COVER
- □ WELL

(XX) RECORDED AS

TAX ID # ISH00135, 136, 137 AND 141

JOB # 13-158



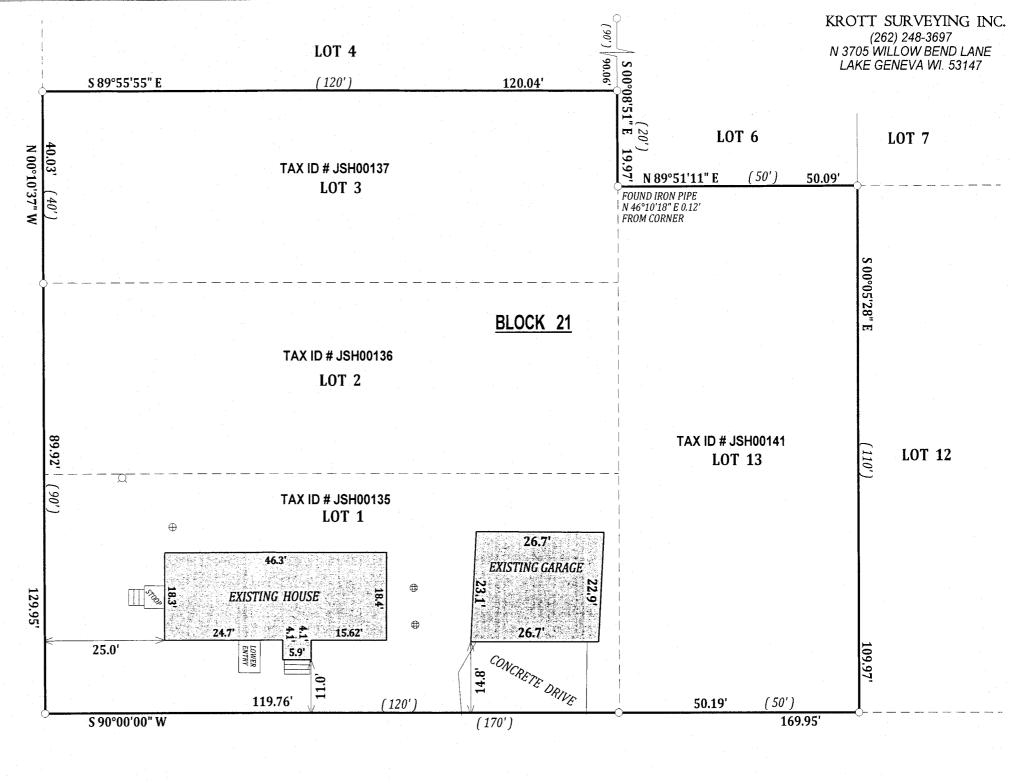

C.L. CLEARVIEW DRIVE

SCALE 1" = 20'

NOTE: BEARINGS ARE REFRENCED TO PREVIOUS SURVEY RECORDS

20 40 60

(40' WIDE)

I have surveyed the above-described property and the above map is a true representation thereof and shows the size and location of the property, its exterior boundaries, the location and dimensions of all structures thereon, fences apparent easements and roadways and visible encroachments. if any.

This survey is made for the exclusive use of the present owners of the property, and also those who puchase, mortgage, or insure the title therto within one (1) year from date hereof; and as to them I warrant the accuracy of said survey map.

J&H -135 J&H -136 TSH-137 TSH-141

217-3935