



PREPARED FOR:
DIANE COCKROFT
KEEFE REAL ESTATE, INC.
751 GENEVA PARKWAY
LAKE GENEVA, WI 53147

PLAT OF SURVEY

-OF-

LOTS 10852 - 10856, BLOCK 196, FIFTH MAP, LAKE COMO
BEACH SUBDIVISION, TOWN OF GENEVA, WALWORTH
COUNTY, WISCONSIN.

KROTT SURVEYING INC.
N3705 WILLOW BEND LANE
LAKE GENEVA WI 53147
PHONE # (262)248-3697
FAX # (262)249-0639

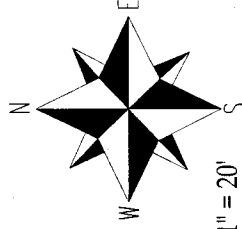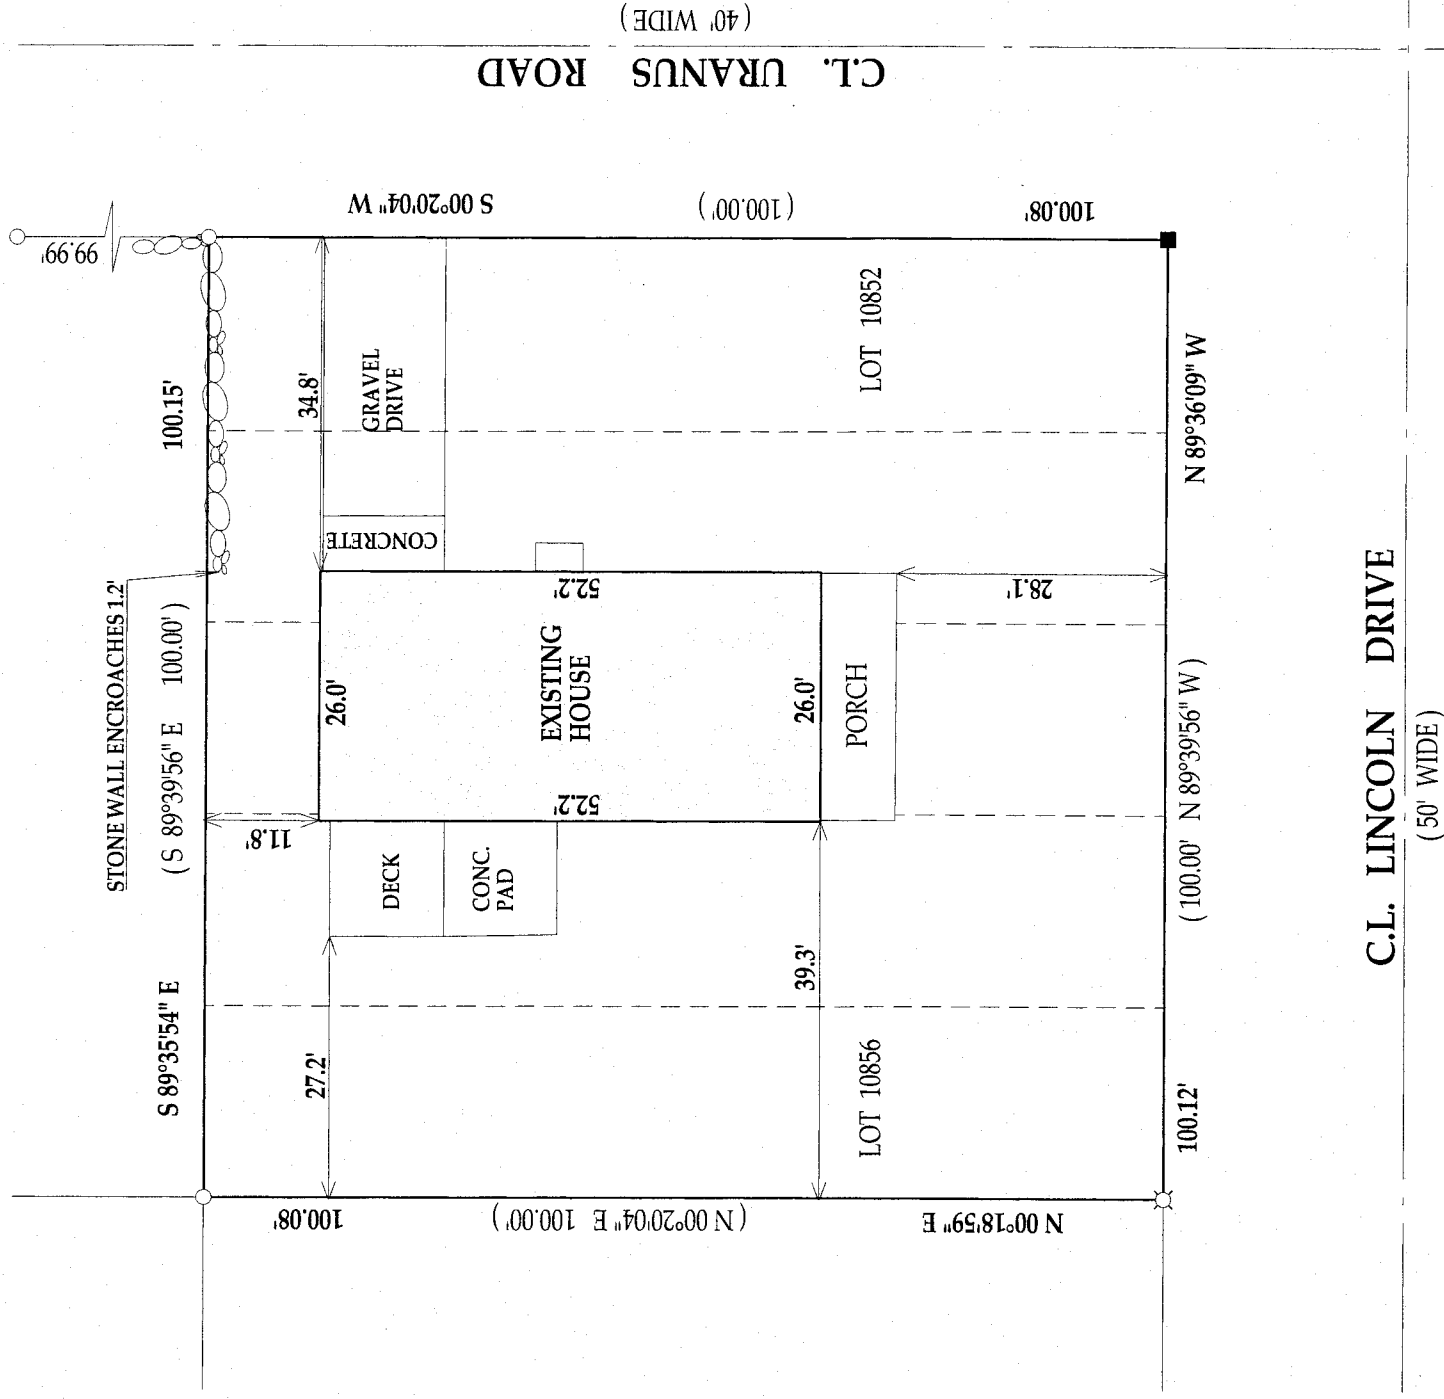


SCALE 1" = 20'

BEARINGS REFERENCED TO THE RECORD PLAT
OF LAKE COMO BEACH

LEGEND

- FOUND IRON PIPE
 - ⊗ FOUND 8 IN. SPK
 - SET IRON BAR
 - (XX) RECORDED AS
- JOB # 01-376 2013
TAX ID #JLCB02359

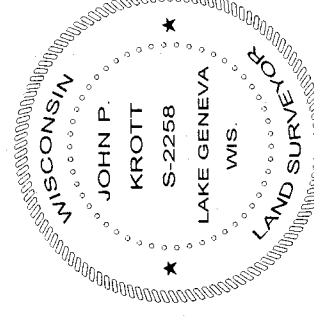

I have surveyed the above-described property and the above map is a true representation thereof and shows the size and location of the property, its exterior boundaries, the location and dimensions of all structures thereon, fences apparent easements and roadways and visible encroachments, if any.

This survey is made for the exclusive use of the present owners of the property, and also those who purchase, mortgage, or insure the title thereto within one (1) year from date hereof; and as to them I warrant the accuracy of said survey map.

DATED THIS 7th, DAY OF NOVEMBER, 2013

John P. Krott

JOHN KROTT S - 2258
Wisconsin Registered Land Surveyor
(original if signed in red)

JLCB 02359

217-3940