


N3705 WILLOW BEND LANE
LAKE GENEVA WI. 53147
PHONE # (262)248-3697
FAX # (262)249-0639


-OF-

LOTS 455 THROUGH 459, INCLUSIVE, IN BLOCK 8 IN LAKE COMO BEACH
THIRD MAP, TOWN OF GENEVA, WALWORTH COUNTY, WISCONSIN.

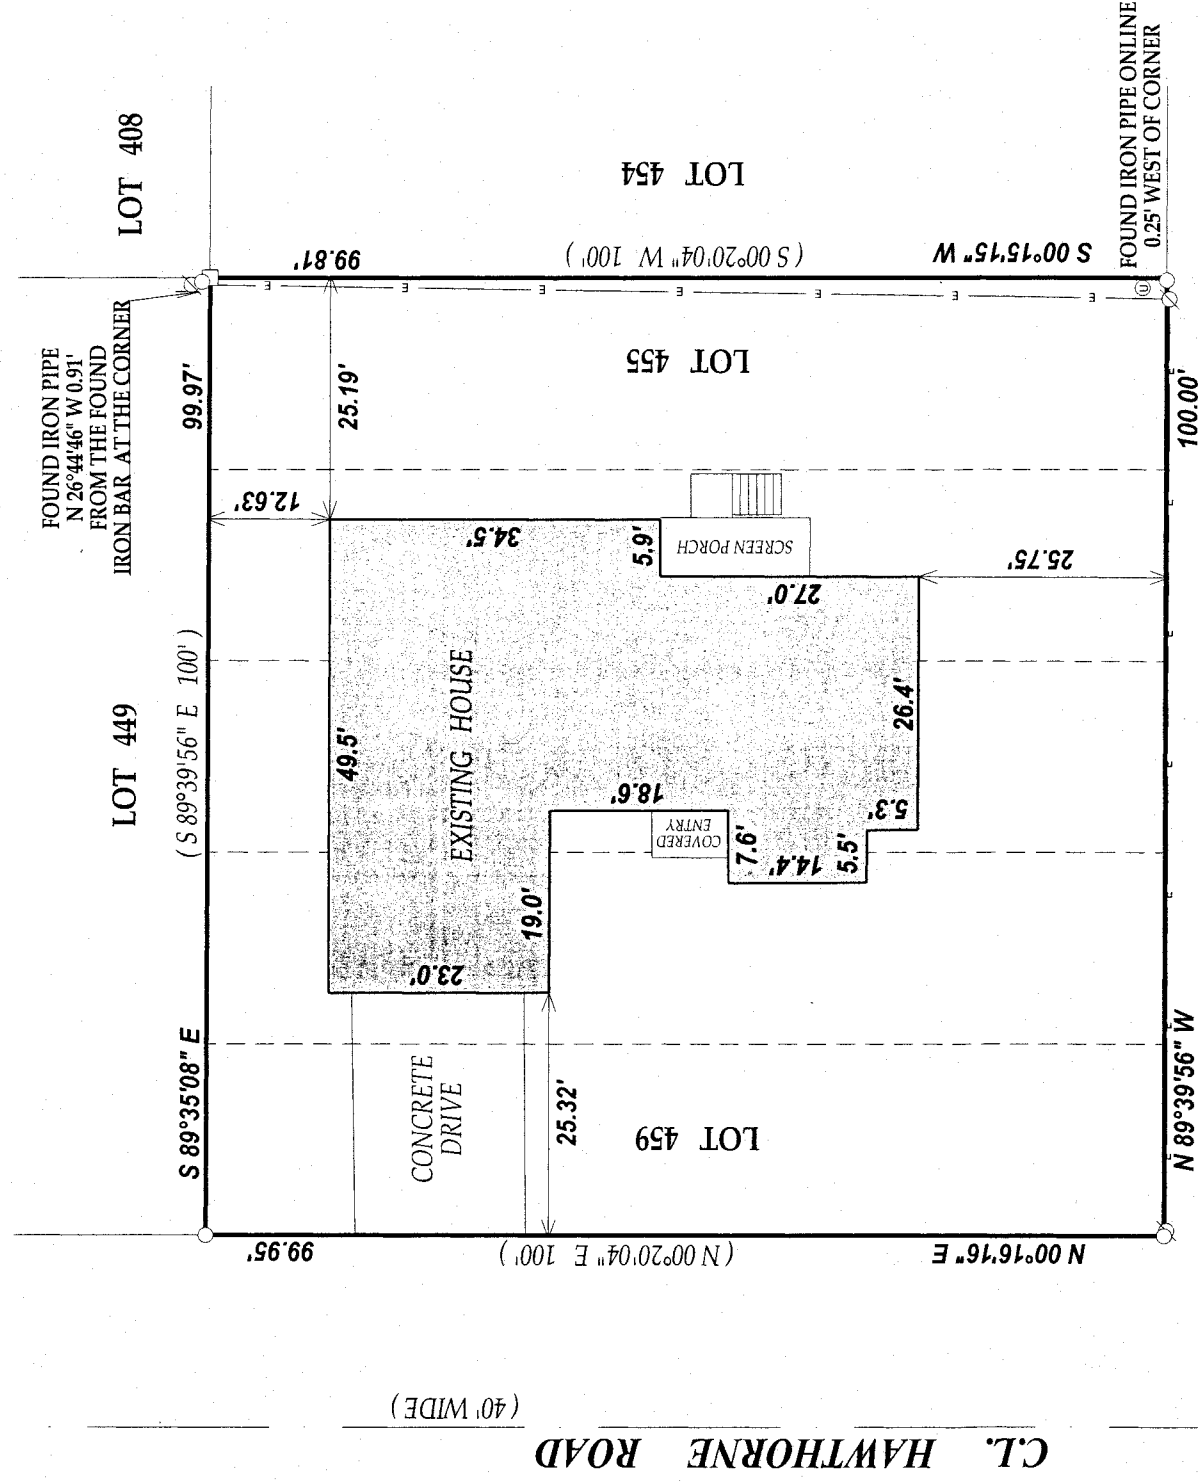

C.L. WASHINGTON DRIVE

UNIMPROVED (40" WIDE)

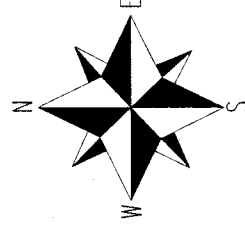

SCALE 1" = 20'



NOTE: BEARINGS ARE REFERENCED TO THE RECORD PLAT OF LAKE COMO BEACH.

I have surveyed the above-described property and the above map is a true representation thereof and shows the size and location of the property, its exterior boundaries, the location and dimensions of all structures thereon, fences apparent easements and roadways and visible encroachments, if any.

This survey is made for the exclusive use of the present owners of the property, and also those who purchase, mortgage, or insure the title thereto within one (1) year from date hereof; and as to them I warrant the accuracy of said survey map.

(XX) RECORDED AS


TAX ID # JLCB00062

JOB # 12-010UD2013

000000330*

DATED THIS 13th DAY OF FEBRUARY 2012

DATE OF LAST REVISION 10/16/2013

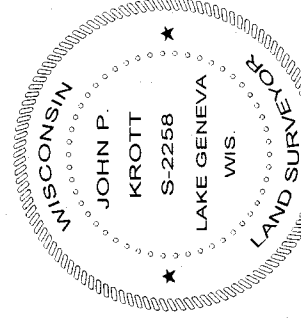

JOHN KROTT S - 2258
Wisconsin Registered Land Surveyor
(original if signed in red)

ILCB-62

217-3941