




PREPARED FOR
THOMAS HANSEN
W3470 LAKESHORE, DR.
LAKE GENEVA, WI 53147

PLAT OF SURVEY


- OF -

LOTS 877, 878, 897, 898, 899, 900 AND 901, BLOCK 15, IN LAKE COMO BEACH,
THIRD MAP, TOWN OF GENEVA, WALWORTH COUNTY, WISCONSIN.

KROTT SURVEYING INC.
(262) 248-3697
N 3705 WILLOW BEND LANE
LAKE GENEVA WI. 53147

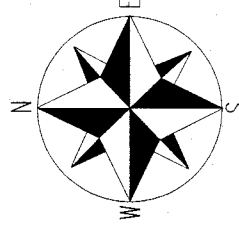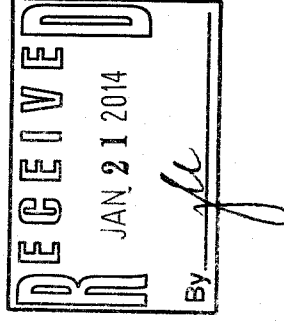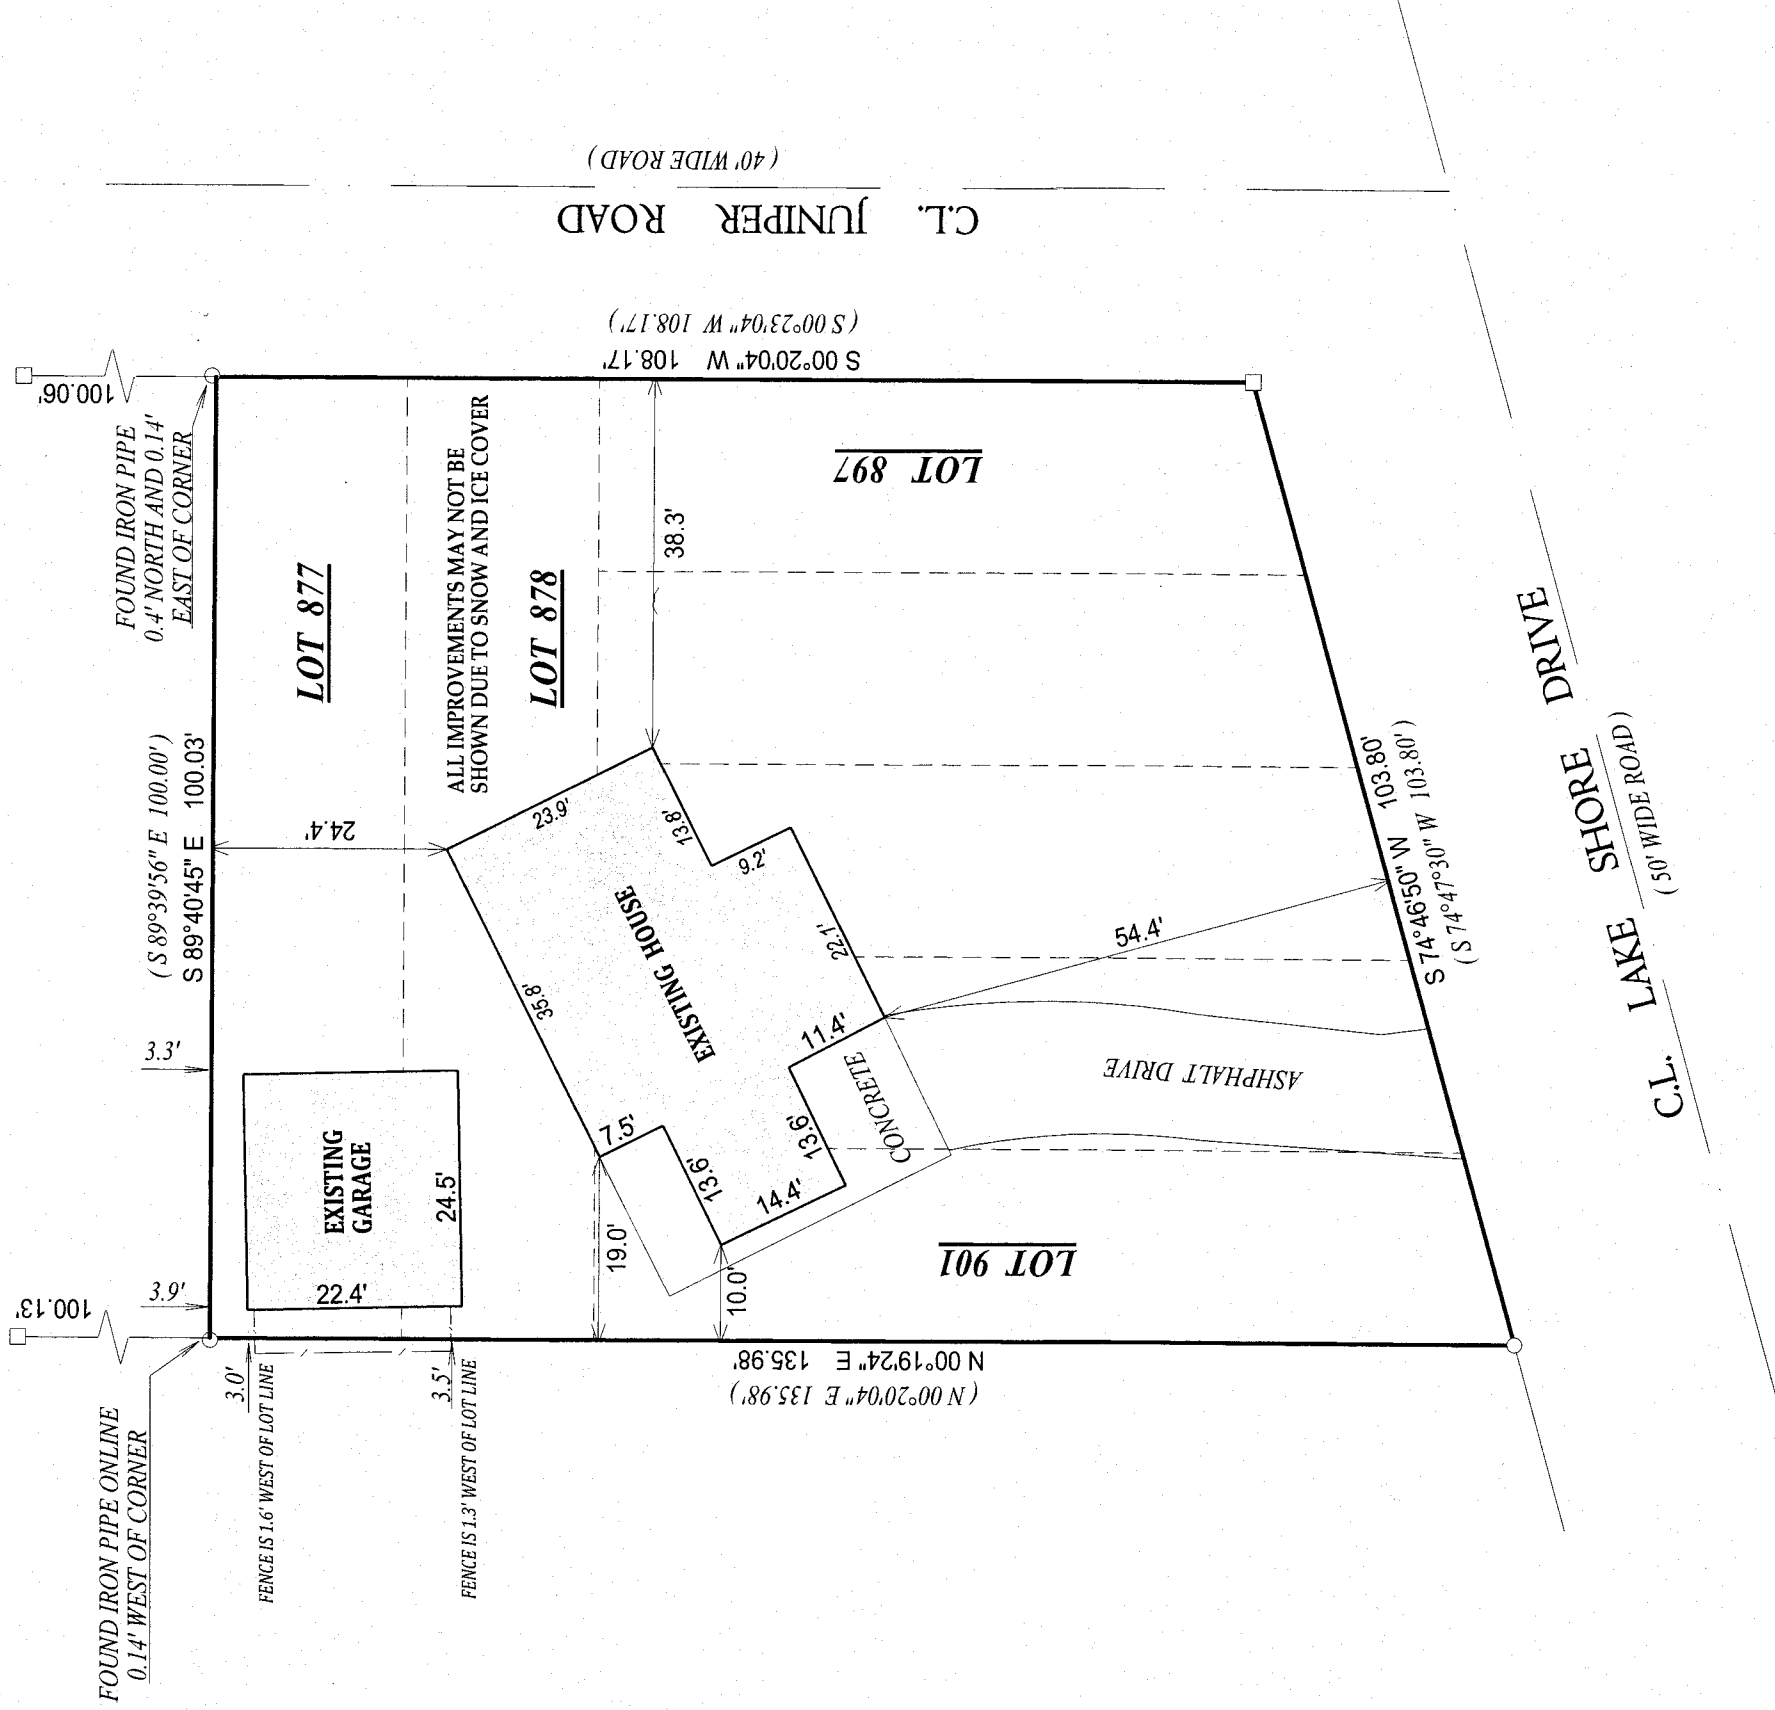

SCALE 1" = 20'
NOTE: BEARINGS ARE REFERENCED TO THE RECORD PLAT.

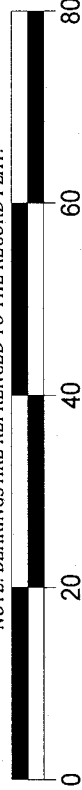

LEGEND

- FOUND IRON PIPE
- FOUND IRON BAR
- WOOD FENCE


(XX) RECORDED AS

TAX ID # JLCB00097C

JOB # 05-339UD2014

I have surveyed the above-described property and the above map is a true representation thereof and shows the size and location of the property, its exterior boundaries, the location and dimensions of all structures thereon, fences, apparent easements and roadways and visible encroachments, if any.

This survey is made for the exclusive use of the present owners of the property, and also those who purchase, mortgage, or insure the title thereto within one (1) year from date hereof; and as to them I warrant the accuracy of said survey map.

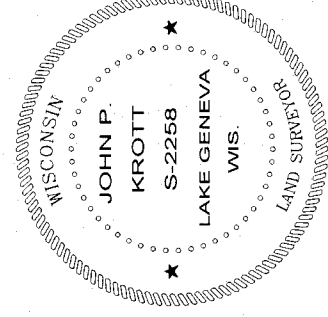

DATED THIS 9th DAY OF JANUARY, 2014

John P. Krott

JOHN P. KROTT S-2258
WISCONSIN REGISTERED LAND SURVEYOR
(NOTE: THIS IS NOT A CERTIFIED COPY
UNLESS SIGNED IN RED INK)

JLCB -97 C 217-3943