

PREPARED FOR  
BASSO BUILDERS  
405 SKYLINE DR.  
LAKE GENEVA WI. 53147

PLAT OF SURVEY

-OF-

LYNCH & ASSOCIATES  
ENGINEERING CONSULTANTS, LLC.  
5482 S. WESTRIDGE DR.  
NEW BERLIN, WI 53151  
(262) 248-3697



LOTS 6816, 6817, 6818, 6820 BLOCK ONE HUNDRED SEVENTEEN (117)  
IN LAKE COMO BEACH SUBDIVISION, IN THE TOWN OF GENEVA,  
COUNTY OF WALWORTH, AND STATE OF WISCONSIN. ALSO LOTS  
6852 AND 6853 BLOCK ONE HUNDRED SEVENTEEN (117) OF LAKE  
COMO BEACH, TOWN OF GENEVA, WALWORTH COUNTY, WISCONSIN.

C.L. LINCOLN DRIVE

(50' WIDE)


C.L. MISTLE ROAD

(40' WIDE)

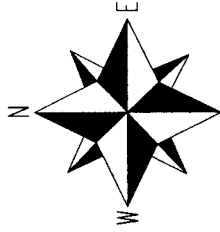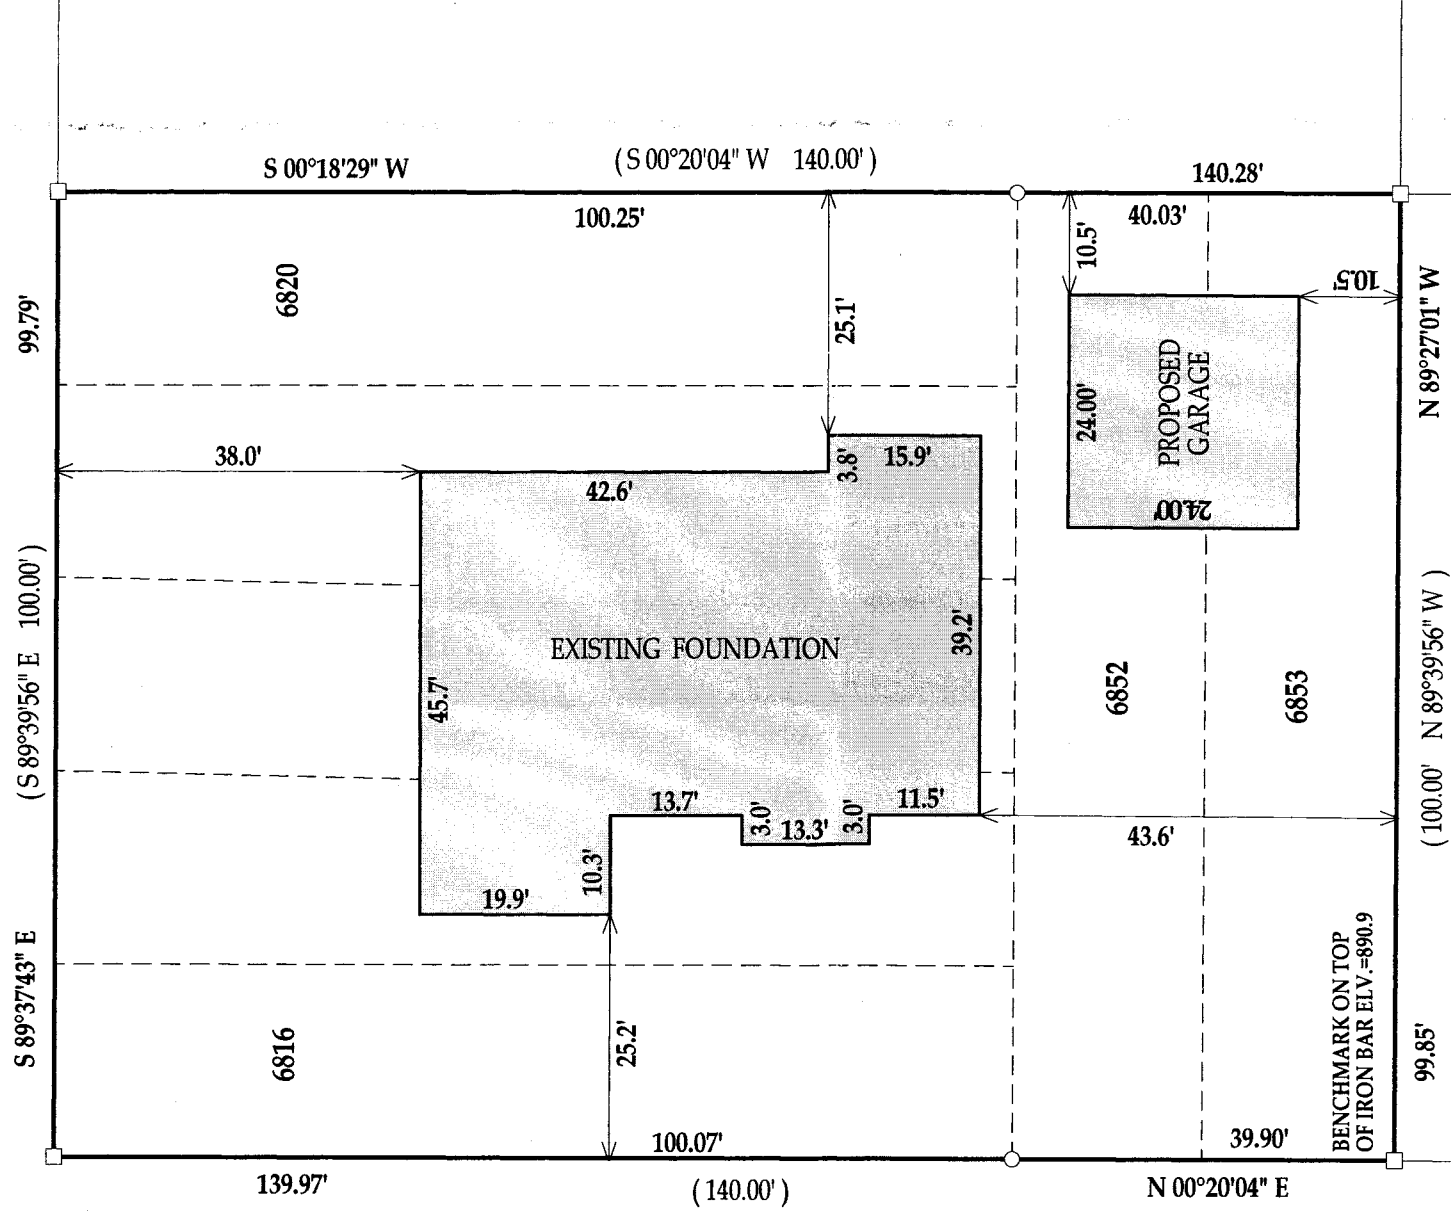

SCALE 1" = 20' S

BEARINGS REFERENCED TO THE RECORD PLAT  
OF LAKE COMO BEACH

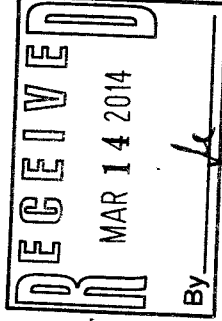

LEGEND

- FOUND IRON PIPE
- FOUND IRON BAR
- (XX) RECORDED AS
- TAX ID # JLCB01432
- JOB # 13-145AB

I have surveyed the above-described property and the above map is a true representation thereof and shows the size and location of the property, its exterior boundaries, the location and dimensions of all structures thereon, fences apparent easements and roadways and visible encroachments, if any.

This survey is made for the exclusive use of the present owners of the property, and also those who purchase, mortgage, or insure the title thereto within one (1) year from date hereof; and as to them I warrant the accuracy of said survey map.

DATED THIS 24th, DAY OF SEPTEMBER, 2013  
DATE OF LAST REVISION: 2/25/2014

*Kenneth B. Mehring*  
KENNETH B. MEHRING S-2838  
Wisconsin Registered Land Surveyor  
(original if signed in red)

217-3952