


PREPARED FOR
EDITH VILLEGAS
N3137 CTY RD "H"
LAKE GENEVA, WI. 53147

[illegible]

Together with easements for ingress and egress as shown on Walworth County Certified Survey Map No. 4191.


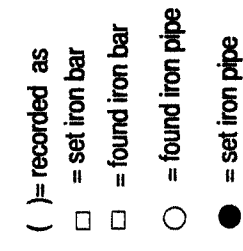


TAX KEY # JG2600007F & JEH00050

"I hereby certify that I have surveyed the above described property and that the above map is a true representation thereof and shows the size and location of all visible structures, apparent easements and encroachments if any."

This survey is made for the present owners of the property, and those who purchase, mortgage, or guarantee the title thereto, within one year from the date hereof.

95-HZL

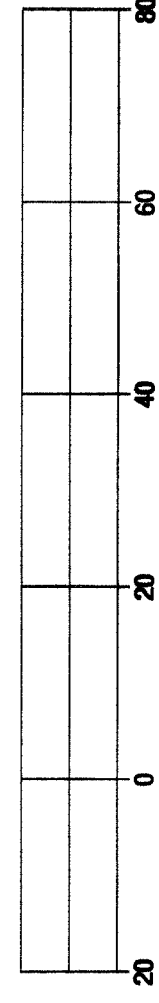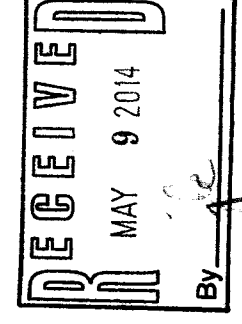

BASIS OF BEARING OF THIS MAP : CERTIFIED SURVEY MAP 2926.