


PLAT OF SURVEY

PATHFINDER SURVEYING INC.
(formerly)
J.K. SURVEYING INC.
P.O BOX 322
LAKE GENEVA, WI. 53147
WWW.PATHFINDERSURVEYING.NET
262-248-8303

LOTS 5432 THRU 5439, BLOCK 98 OF LAKE COMO BEACH
SUBDIVISION, LOCATED IN TOWN 2 NORTH, RANGE 17 EAST,
TOWN OF GENEVA, COUNTY OF WALWORTH, STATE OF
WISCONSIN.

-OF-

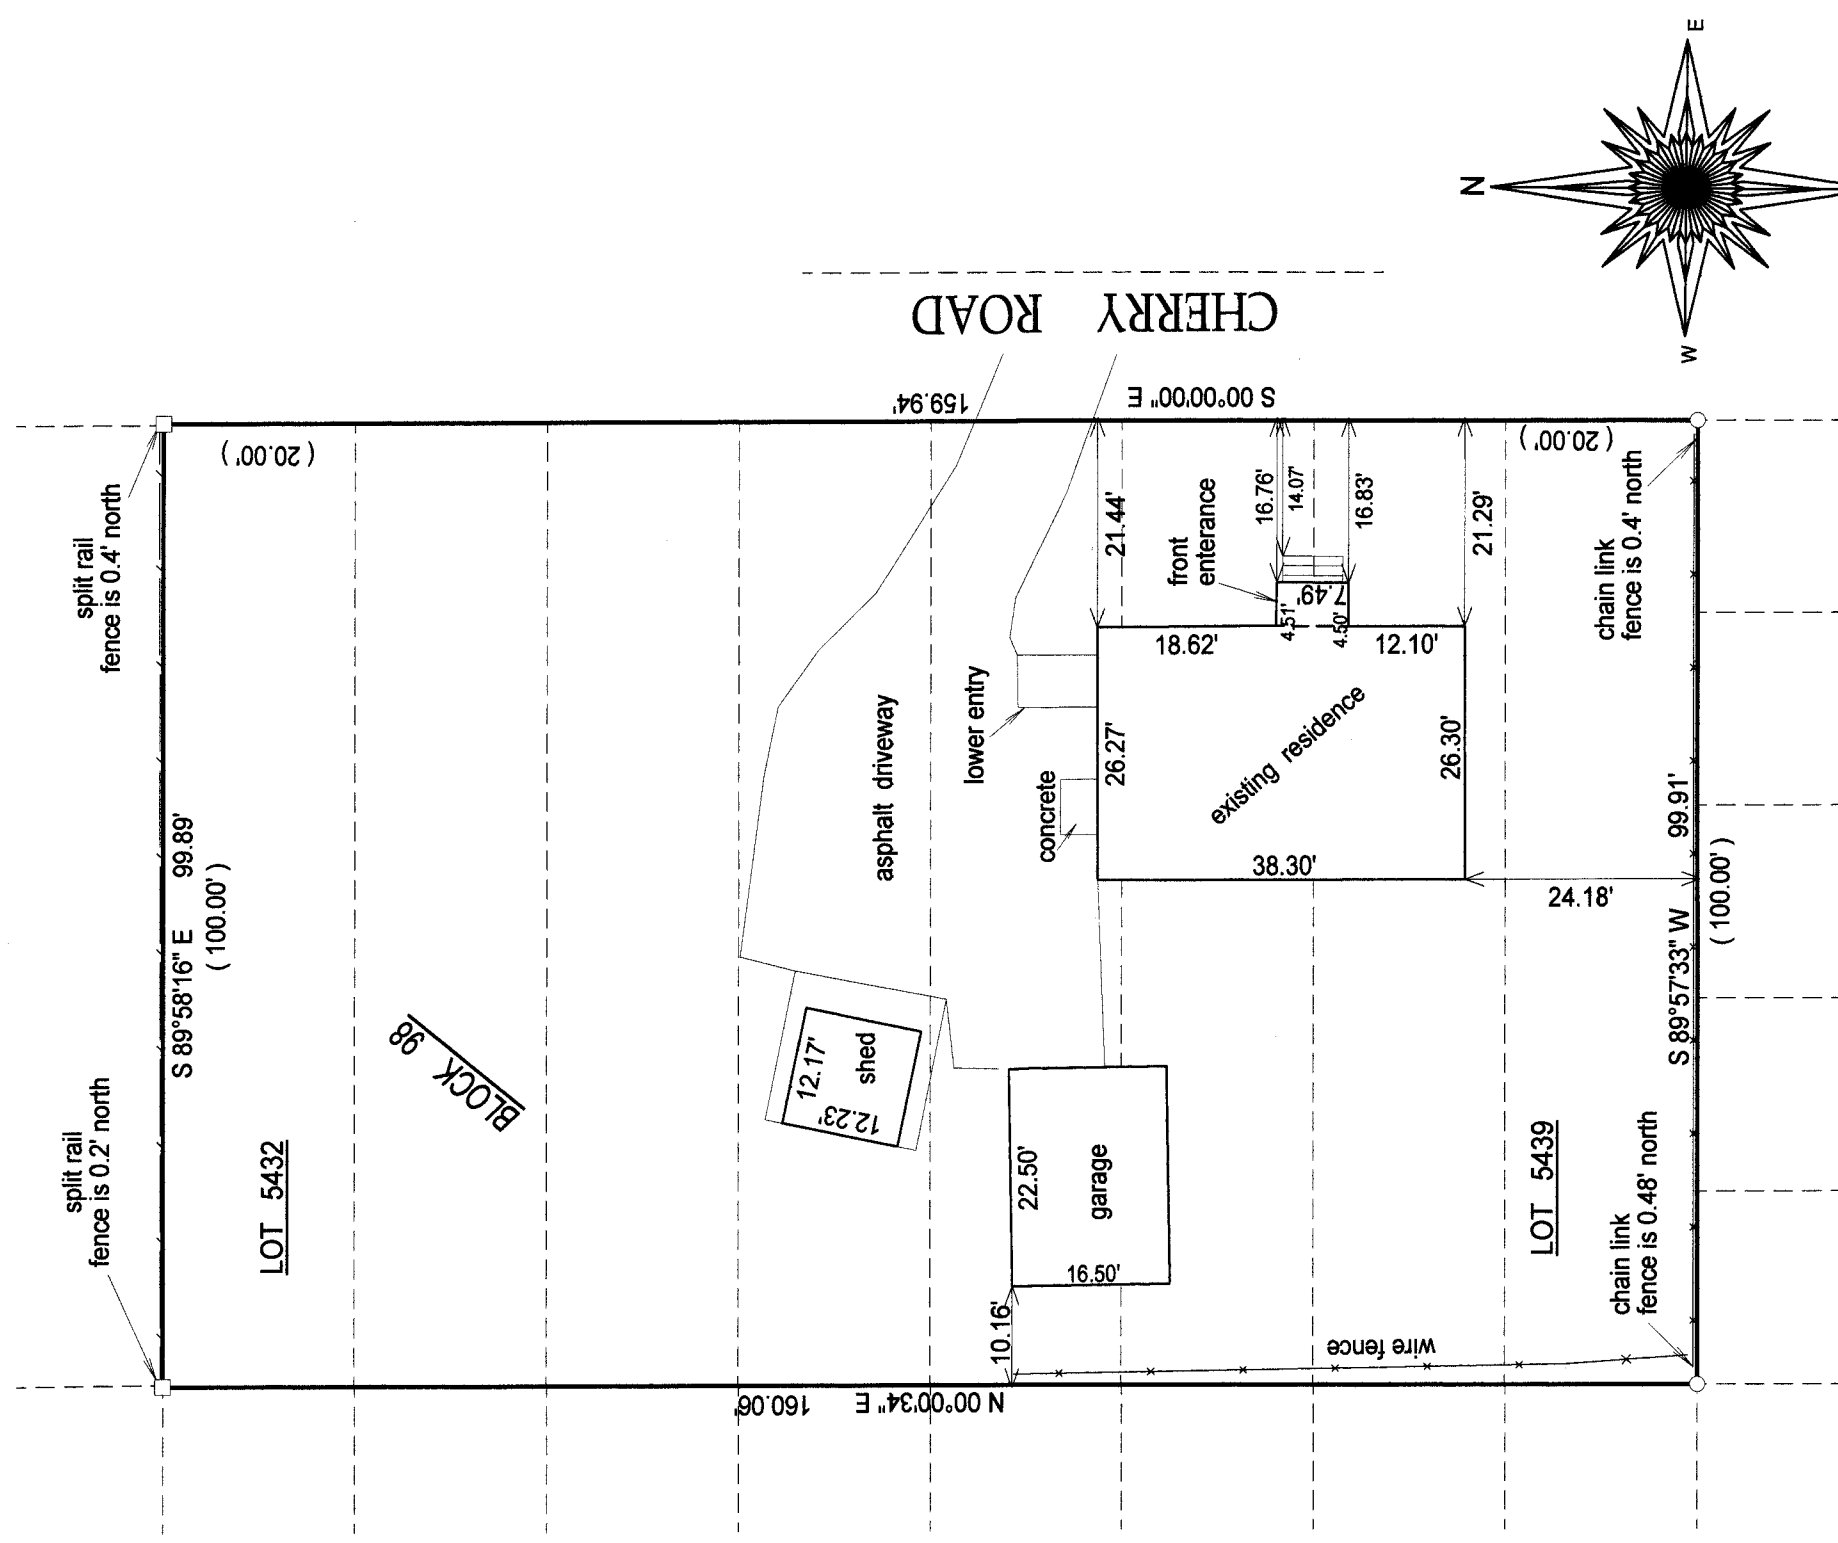

- () = recorded as
- = found iron bar
- = found iron pipe
- = set iron pipe
- = set iron bar

SCALE 1" = 20'

JOB # 13-197

TAX ID # JLCB01100

BASIS OF BEARING OF THIS PLAT: THE WEST LINE OF CHERRY ROAD WAS ASSUMED TO BEAR NORTH.

I hereby certify that I have surveyed the above-described property and the above map is a true representation thereof and shows the size and location of the property, its exterior boundaries, the location and dimensions of all structures thereon, fences, apparent easements and roadways and visible encroachments if any.

This survey is made for the present owners of the property, and those who purchase, mortgage, or guarantee the title thereto, within one year from the date hereof.

DATED THIS 8TH DAY OF OCTOBER, 2013.

TCB-1100

217-3965

JEFFREY L KIMPS S - 2436
Wisconsin Registered Land Surveyor
(original if signed in red)