



WORK ORDERED BY -  
BASSO BUILDERS  
405 SKYLINE DRIVE  
LAKE GENEVA, WI. 53147

FARRIS, HANSEN & ASSOCIATES, INC.  
Engineering, Architecture, Surveying  
7 Ridgeway Court P.O. Box 437  
ELKHORN, WISCONSIN 53121  
Office: (262) 723-2098  
Fax: (262) 723-5886


REVISIONS

PROJECT NO.  
3269.03.35  
DATE:  
05/12/05  
SHEET NO.  
1 OF 1

# PLAT OF SURVEY

UNIT 3-35  
GENEVA NATIONAL CONDOMINIUM  
NO. 3

LOCATED IN TOWN 2 NORTH, RANGE 17 EAST  
WALWORTH COUNTY, WISCONSIN

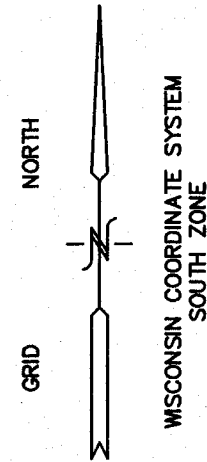

UNIT 3-42

UNIT 3-34

UNIT 3-35  
21,905 S.F.

UNIT 3-41

UNIT 3-40

UNIT 3-36

UNIT 3-39

AS BUILT  
RESIDENCE

BENCH MARK  
CHISELED "X" ON  
RIM SANITARY MH  
ELEV.=1068.20'  
(IE=1048.90')

EXTG. EDGE OF  
PAVEMENT

(IE=1057.0')

NO CULVERT  
REQUIRED



EXTG. HYDRANT  
W/ AUX. VALVE

WILMINGTON WAY  
PRIVATE ROADWAY

EXTG. 12" CMP  
IE=1066.8' W.  
IE=1066.0' E.

EXTG. SANI.  
MANHOLE  
(RIM=1062.41')  
(IE=1047.85')

LEGEND  
● = FOUND IRON REBAR STAKE  
(xxx) = RECORDED AS

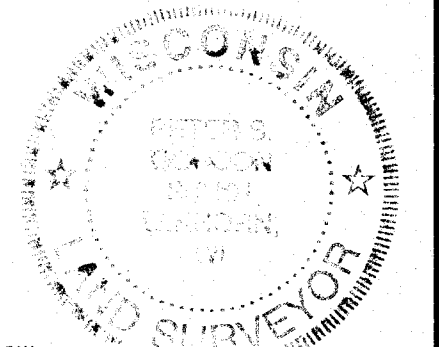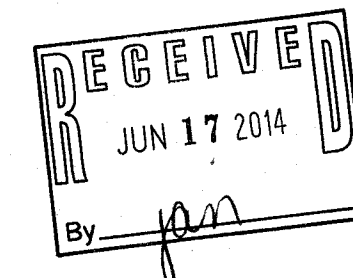

NOTE: COPIES OF THIS MAP TO WHICH THE FOLLOWING CERTIFICATE WILL APPLY SHOW  
SURVEYOR'S ORIGINAL SEAL AND SIGNATURE IN RED INK. COPIES BY ANY OTHER MEANS MAY  
HAVE ALTERATIONS WHICH DO NOT REPRESENT THE SURVEYOR'S WORK PRODUCT.


I HEREBY CERTIFY THAT THE ABOVE DESCRIBED PROPERTY HAS BEEN SURVEYED UNDER MY  
DIRECTION AND THAT THE ABOVE MAP IS A TRUE REPRESENTATION THEREOF AND SHOWS THE SIZE  
AND LOCATION OF THE PROPERTY, ITS EXTERIOR BOUNDARIES, THE LOCATION OF ALL VISIBLE  
STRUCTURES, AND DIMENSIONS OF ALL PRINCIPLE BUILDINGS THEREON, BOUNDARY FENCES,  
APPARENT EASEMENTS, ROADWAYS, AND VISIBLE ENCROACHMENTS, IF ANY. THIS SURVEY IS MADE  
FOR THE USE OF THE PRESENT OWNERS OF THE PROPERTY, AND ALSO THOSE WHO PURCHASE,  
MORTGAGE, OR GUARANTEE THE TITLE THERETO WITHIN ONE YEAR FROM THE DATE HEREOF.

DATED: MAY 17, 2005

RESURVEYED AND RECERTIFIED  
08-08-2013

REVISED 05-21-2014  
TO SHOW SIZE & LOCATION OF  
AS BUILT RESIDENCE

REVISOR: 10/25/2013-KB  
SITE, GRADING, DRAINAGE &  
EROSION CONTROL PLAN  
PETER S. GORDON R.L.S. 2101

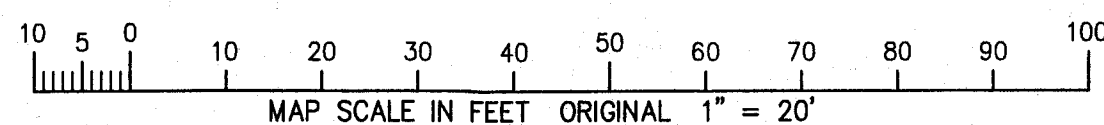

MAY 21 2014

JGN 3-35

217-3971