
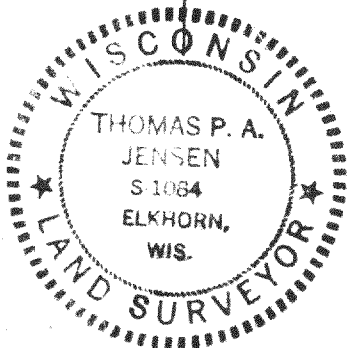


PLAT OF SURVEY

OF

LOTS 10740 TO 10745 INCLUSIVE, BLOCK 194, LAKE COMO BEACH, A SUBDIVISION LOCATED IN TEN RITE, WALKWORTH COUNTY, WISCONSIN.

LONGFELLOW DRIVE 40' WIDE

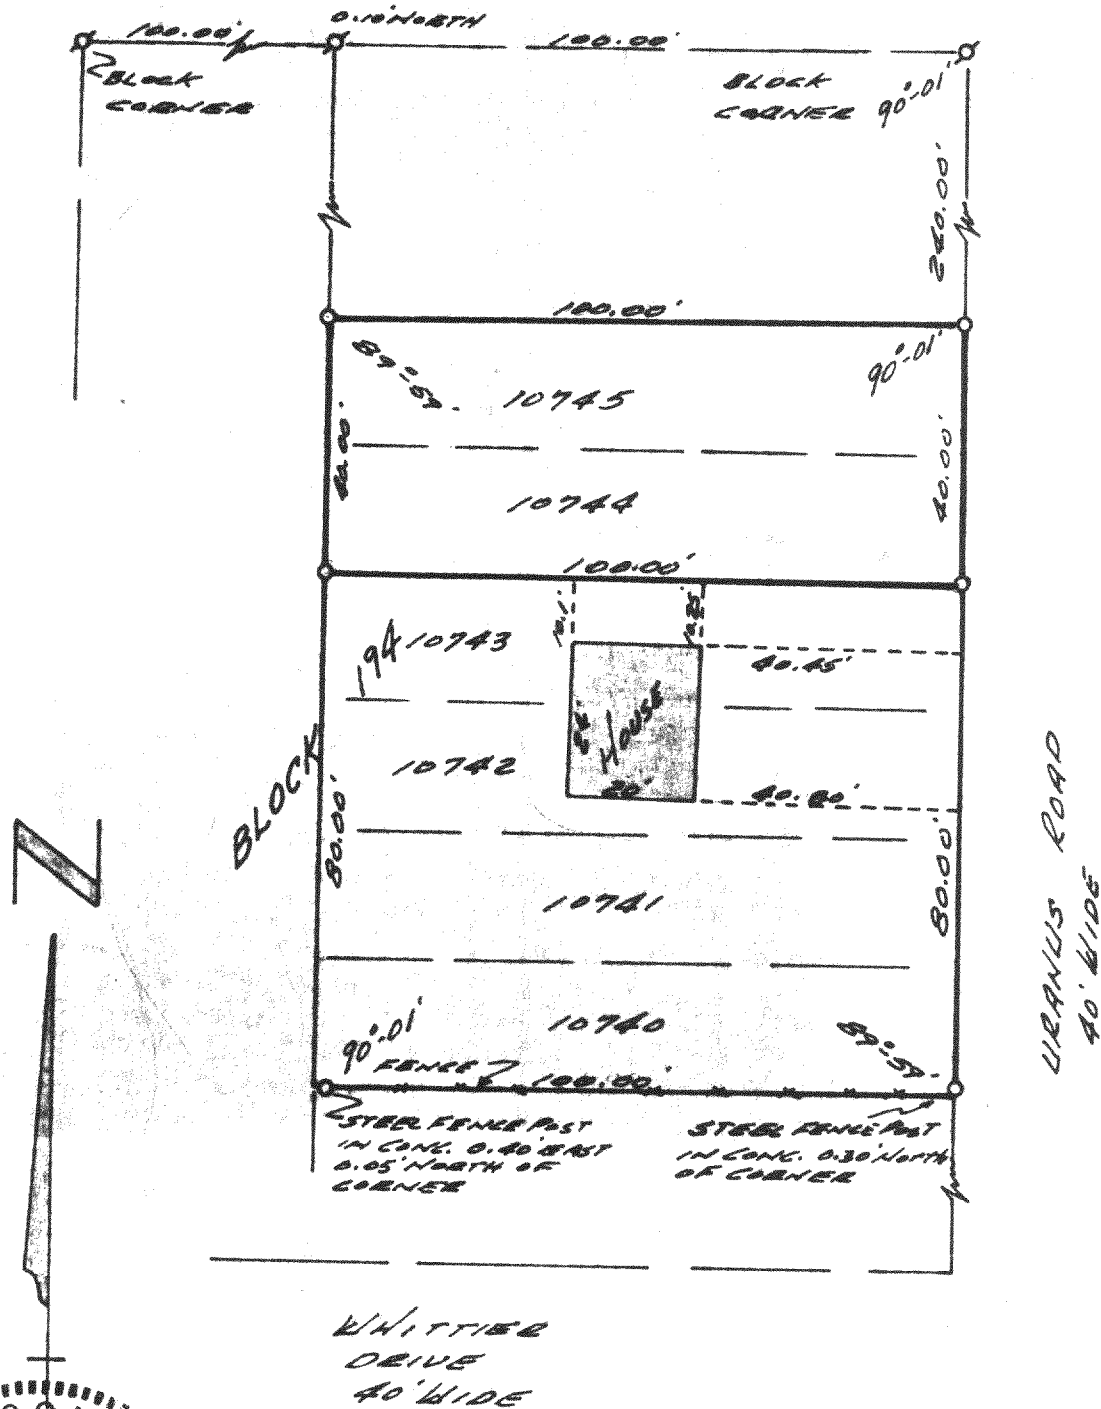

LEGEND

- — Iron Pipe SET
- — Concrete Monument

Scale 1" = 30'

Ø — IRON PIPE FOUND

BLOCK CORNER
BLOCK 193

SURVEY AND PLAT BY

JENSEN & JOHNSON, INC.
CIVIL ENGINEERS AND SURVEYORS

Elkhorn, Wisconsin

WE CERTIFY: That we have surveyed the above described property and that the plat shown hereon is an accurate survey and a true representation thereof and correctly shows the exterior boundary lines and all divisions of said property, AND ALL BUILDINGS THEREON.

Date JULY 25, 1974 Thomas P. A. Jensen

217-401

Wisconsin Registered Land Surveyor, No. S-1064

JLB-2331