
PLAT OF SURVEY -OF-

LOTS 7053-7057 BLOCK 121, LAKE COMO BEACH, A SUBDIVISION LOCATED IN TOWN 2 NORTH, RANGE 17 EAST OF THE FOURTH PRINCIPAL MERIDIAN, WALWORTH COUNTY, WISCONSIN.
SURVEY FOR: CLIFF CANOVI

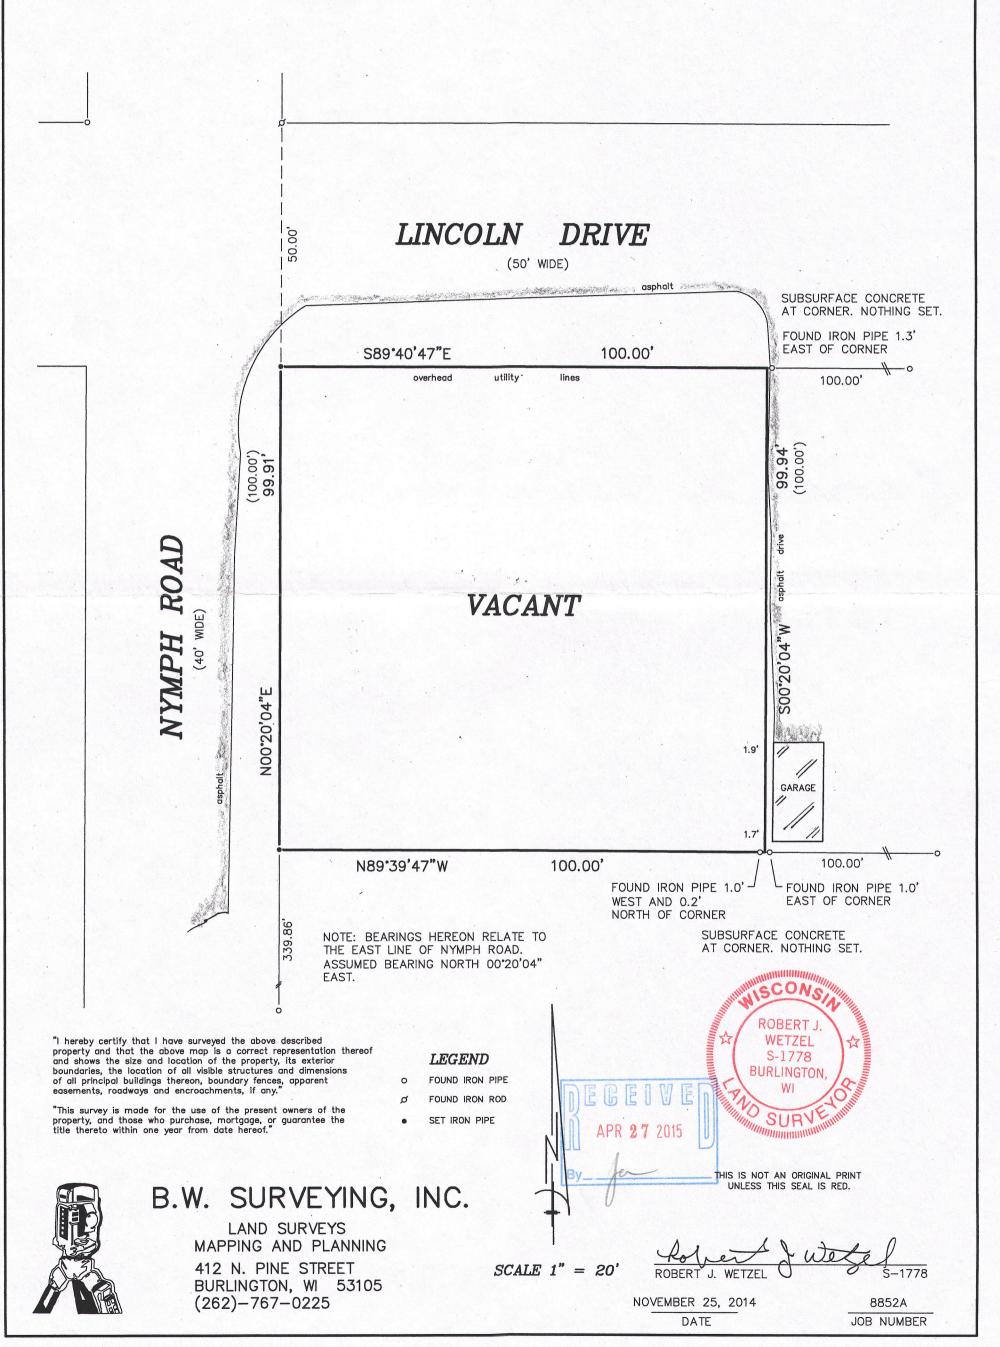

JLCB-1492 217-4062