
PREPARED FOR: BASSO BUILDERS 405 SKYLINE DRIVE LAKE GENEVA, WI 53147

PLAT OF SURVEY

--0F-

LOTS 6409 THRU 6413, BLOCK 111, LAKE COMO BEACH SUBDIVISION, LOCATED IN SECTION 28, TOWN 2 NORTH, RANGE 17 EAST, TOWN OF GENEVA, WALWORTH COUNTY, WISCONSIN. LYNCH & ASSOCIATES ENGINEERING CONSULTANTS, LLC.

405 SKYLINE DRIVE, SUITE C LAKE GENEVA, WI 53147 (262) 248-3697

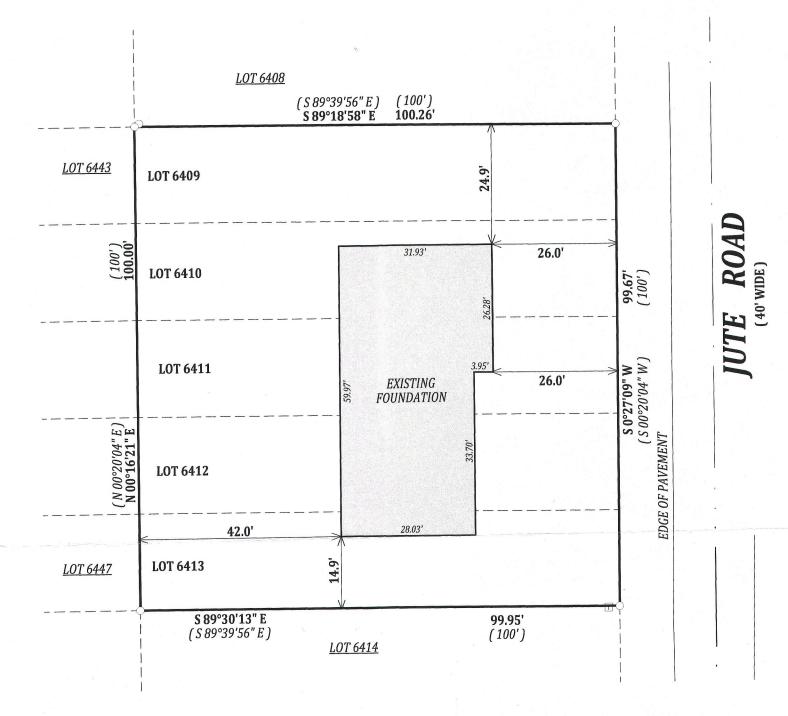

<u>LEGEND</u>

O FOUND 1" IRON PIPE

(XX) RECORDED AS

OVERHEAD UTILITY
LINE

∅ POWER POLE

□ UTILITY PEDISTAL

E UNGERGROUND ELECTRIC LINE

MANHOLE

SCALE 1" = 20'
20 40 60

BEARINGS HEREON REFERENCED TO THE RECORDED PLAT.

ELEVATIONS ARE ASSUMED

JOB # 15-539 TAX ID # JLCB01329 This survey is made for the exclusive use of the present owners of the property, and also those who puchase, mortgage, or insure the title therto within one (1) year from date hereof; and as to them I warrant the accuracy of said survey map.

No title commitment or reults of a title search were provided to

this office pertaining to this survey. This Plat Of Survey may not

I have surveyed the above-described property and the above map is a true representation thereof and shows the size and location of the

property, its exterior boundaries, the location and dimensions of all

structures thereon, fences apparent easements and roadways and

reflect easements of record, encumbrances, restrictions, ownership, title evidence, or other facts that a current and

JUL 1 2015

NOTE:

accurate title search may disclose.

visible encroachments. if any.

KENNETH

B.

MEHRING

*

S-2838

WATERFORD

WIS.

SURVING

DATED THIS 3rd DAY OF APRIL, 2015 LAST REVISED THIS 29th DAY OF MAY, 2015

KENNETH B. MEHRING S - 2838
Wisconsin Registered Land Surveyor
(original if signed in red)

JLCB-1329

217-4087