


PREPARED FOR:  
THANKSGIVING PROPERTIES, LLC  
P.O. BOX 370  
WALWORTH, WI 53184

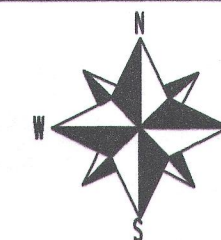

BEARINGS HEREON REFERENCED  
TO THE WISCONSIN COUNTY  
COORDINATE SYSTEM,  
WALWORTH COUNTY ZONE.  
ALL ELEVATIONS RELATE TO  
NAVD-88



LYNCH & ASSOCIATES  
ENGINEERING CONSULTANTS, LLC

405 SKYLINE DRIVE, SUITE C  
LAKE GENEVA, WI 53147  
(262) 248-3697

| NO. | REVISIONS | BY | DATE |
|-----|-----------|----|------|
|     |           |    |      |
|     |           |    |      |
**TOPOGRAPHIC PLAT OF SURVEY**  
-OF-  
**PART OF BLOCK 162**  
**LAKE COMO BEACH 4TH MAP**  
**TOWN OF GENEVA, WALWORTH COUNTY, WISCONSIN**


| INITIALS     | DATE     |
|--------------|----------|
| DESIGNED KBM | 5/20/15  |
| DRAWN KBM    | 5/20/15  |
| CHECKED XXX  | XX/XX/XX |

0 20'  
SCALE

PROJECT NO.  
**15-569**

SHEET NO.

**1** OF **1**

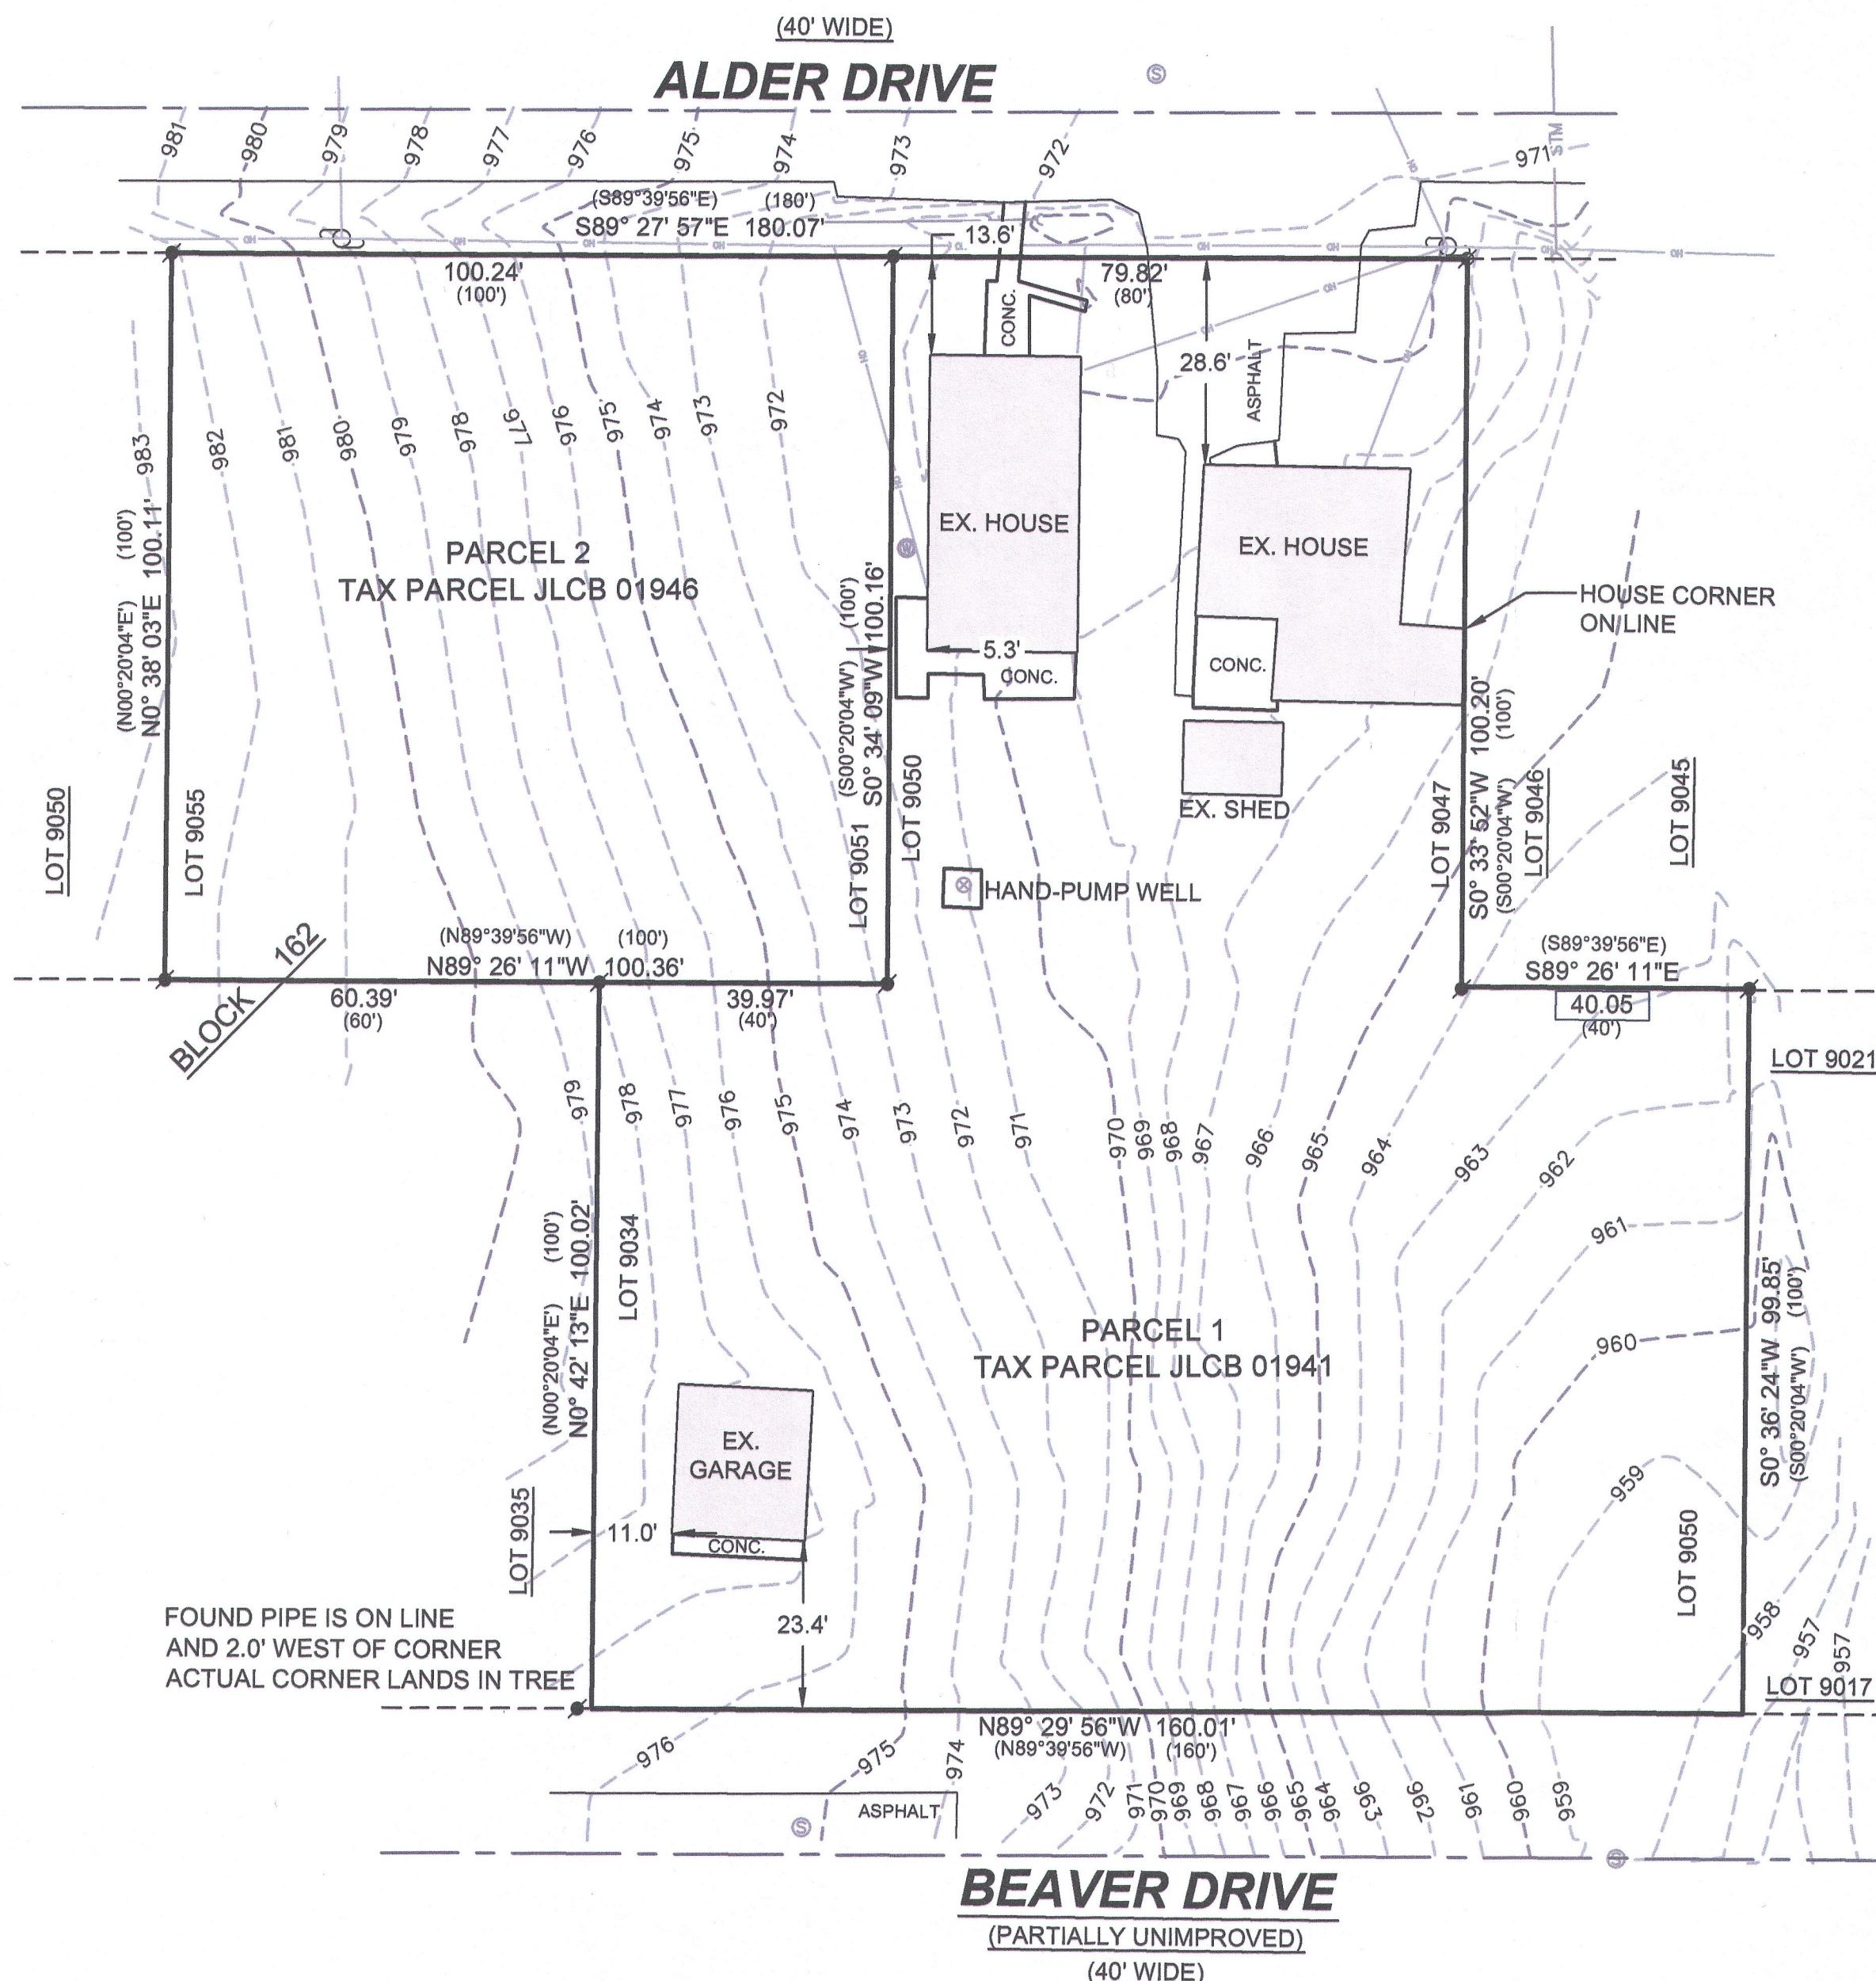



**LEGAL DESCRIPTIONS:**

**PARCEL 1:**  
LOTS 9027-9034, INCLUSIVE, AND LOTS 9047-9050 INCLUSIVE, BLOCK 162, LAKE COMO BEACH 4TH MAP, ACCORDING TO THE RECORDED PLAT THEREOF. SAID LAND BEING IN THE TOWN OF GENEVA, COUNTY OF WALWORTH, STATE OF WISCONSIN.

**PARCEL 2:**  
LOTS 9051-9055, INCLUSIVE, BLOCK 162, LAKE COMO BEACH 4TH MAP, ACCORDING TO THE RECORDED PLAT THEREOF. SAID LAND BEING IN THE TOWN OF GENEVA, COUNTY OF WALWORTH, STATE OF WISCONSIN.

**LEGEND**

- FOUND 1" IRON PIPE
- FOUND 5/8" IRON BAR
- (XX) RECORDED AS
- WELL
- MANHOLE
- POWER POLE

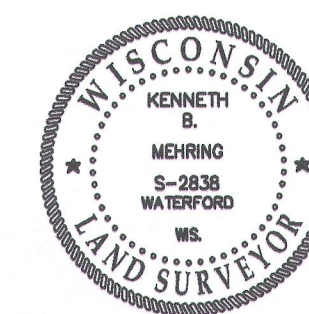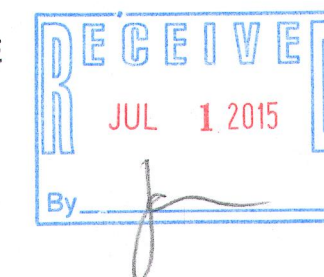

**KENNETH B. MEHRING S-2838**  
**WISCONSIN REGISTERED**  
**LAND SURVEYOR**  
(original if signed in red)

**NOTE:**  
No title commitment or results of a title search were provided to this office pertaining to this survey. This Plat Of Survey may not reflect easements of record, encumbrances, restrictions, ownership, title evidence, or other facts that a current and accurate title search may disclose.

I have surveyed the above-described property and the above map is a true representation thereof and shows the size and location of the property, its exterior boundaries, the location and dimensions of all structures thereon, fences, apparent easements and roadways, and visible encroachments, if any.

This survey is made for the exclusive use of the present owners of the property, and also those who purchase, mortgage, or insure the title thereto within one (1) year from date hereof; and as to them I warrant the accuracy of said survey map.

JOB # 15-569  
TAX ID # AS NOTED ON MAP

FILENAME: C:\1. Projects\2015\15.569 Thanksgiving Properties - Alder\15569 TOPO.dwg

PLOT DATE: 5/20/2015 2:48 PM  
JLCB-1941  
JLCB-1946

217-4090