PREPARED FOR MARGRET CANFIELD @ PROPERTIES LAKE GENEVA WI.

TAX ID # JLCB 01965 & JLCB 01963`

PLAT OF SURVEY

OF-

LOTS 9132 THRU 9145, BLOCK 164 LAKE COMO BEACH SUBDIVISION, LOCATED IN TOWN 2 NORTH, RANGE 17 EAST, TOWN OF GENEVA, COUNTY OF WALWORTH AND STATE OF WISCONSIN.

CYPRESS DRIVE

(platted as 40' wide)

PATHFINDER SURVEYING INC.


(formerly)

J.K. SURVEYING INC.

P.O BOX 322

LAKE GENEVA, WI. 53147

WWW.PATHFINDERSURVEYING.NET
262-248-8303

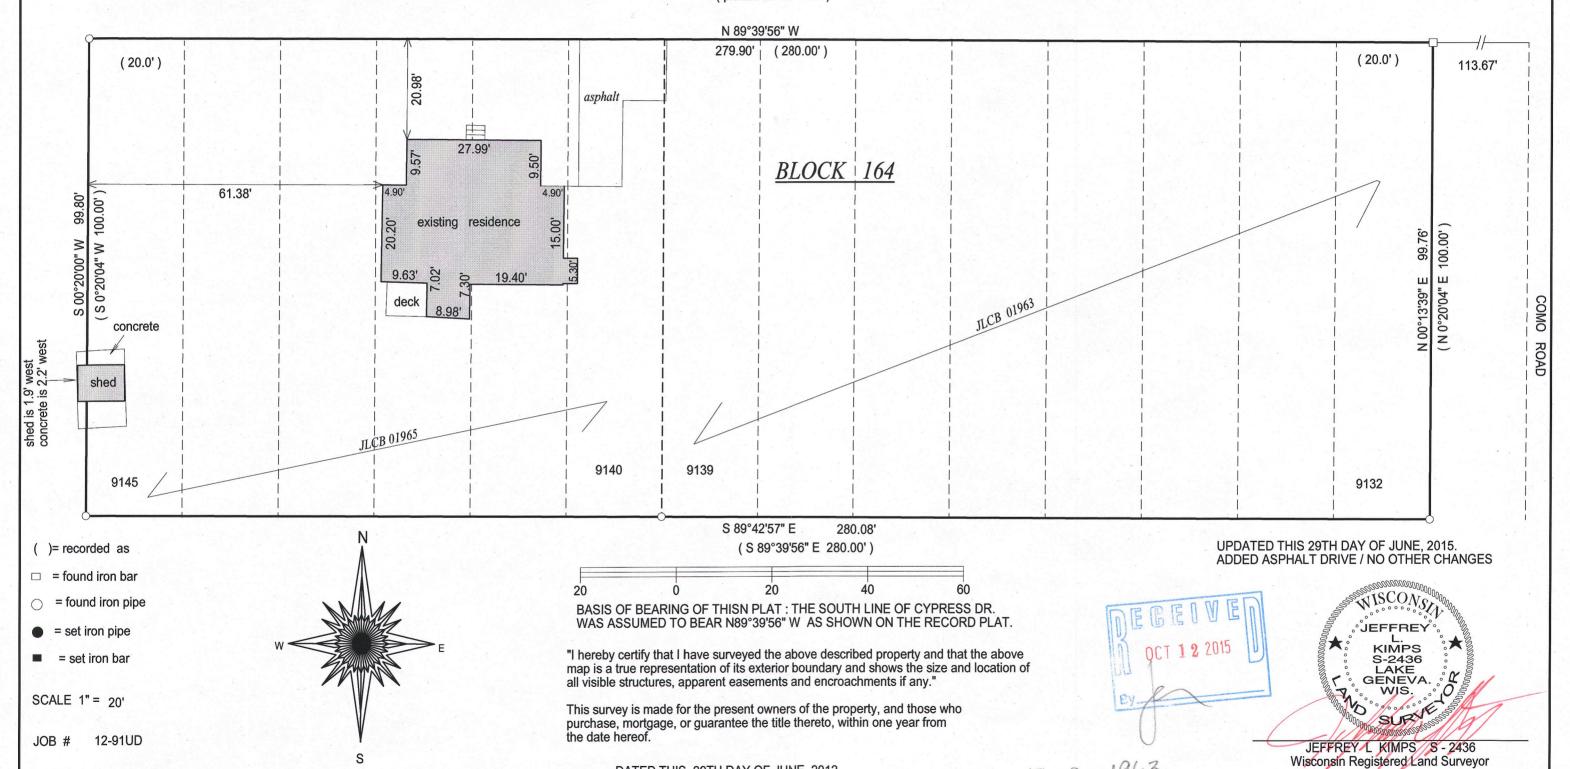

DATED THIS 29TH DAY OF JUNE, 2012.

JUCB-1965

217-4114

(original if signed in red)