

PLAT OF SURVEY

LEGAL DESCRIPTION


LOCATED IN THE SOUTHWEST 1/4 OF THE SOUTHEAST 1/4,
SECTION 21, TOWNSHIP 2 NORTH, RANGE 17 EAST, IN THE
TOWN OF GENEVA, WALWORTH COUNTY, WISCONSIN.

LOTS 9235 THRU 9242 INCLUSIVE AND LOTS 9255 THRU 9260
INCLUSIVE, ALL IN BLOCK 166 OF LAKE COMO BEACH FOURTH MAP.

SITE ADDRESS: W3833 ALDER DR., LAKE GENEVA

OWNER: ALICE JOHANSON & DONALD JOHANSON
6927 N. OLCOTT AVE.
CHICAGO, IL. 60631

COMO RD.

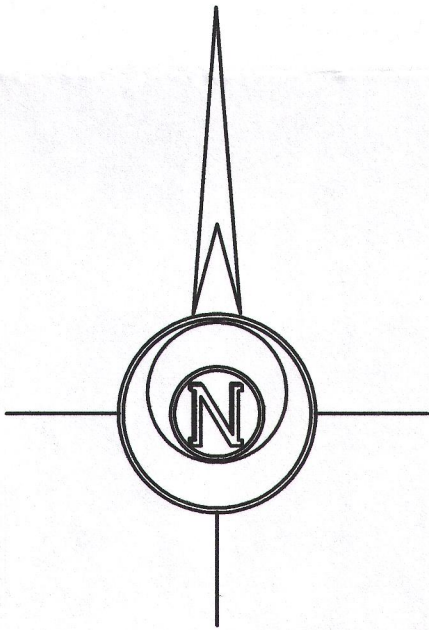

BASIS OF BEARINGS:
THE SOUTH LINE OF ALDER DR.
BEING N 89°39'56" W

LEGEND

- FOUND IRON PIPE
- FOUND IRON ROD
- FOUND COUNTY MONUMENT
- FOUND CONCRETE MONUMENT
- CHISEL CUT IN CONCRETE
- SET IRON ROD, 18" LONG, WEIGHING
1.5 LBS./LINEAL FT., 3/4" DIA.
- RECORDED AS DIMENSION
- EXISTING FENCE

SCALE: 1 INCH= 20 FEET

"I hereby certify that the above described property has
been surveyed by me or under my direction and that the
above map is a true representation thereof and shows the
size and location of the property, its exterior boundaries,
the location of all visible structures and dimensions of all
principal buildings thereon, boundary fences, apparent
easements, roadways and visible encroachments, if any."
"This survey is made for the use of the present owners of
the property, and also those who purchase, mortgage, or
guarantee the title thereto within one year from date
hereof."

Mark L. Miritz
MARK L. MIRITZ
WISCONSIN PROFESSIONAL
LAND SURVEYOR S-2582

REVISED OCT. 14, 2016 TO SHOW
FOUNDATION "AS BUILT"

DATE: 5/18/2016 GP JOB NO. 16.501

