


FARRIS, HANSEN & COOPER, INC.

ENGINEERING, SURVEYING AND LAND PLANNING
715 W. WALWORTH ST. - P.O. BOX 487 - ELKHORN, WI 53121

CLUB HOUSE DRIVE - 50' WIDE

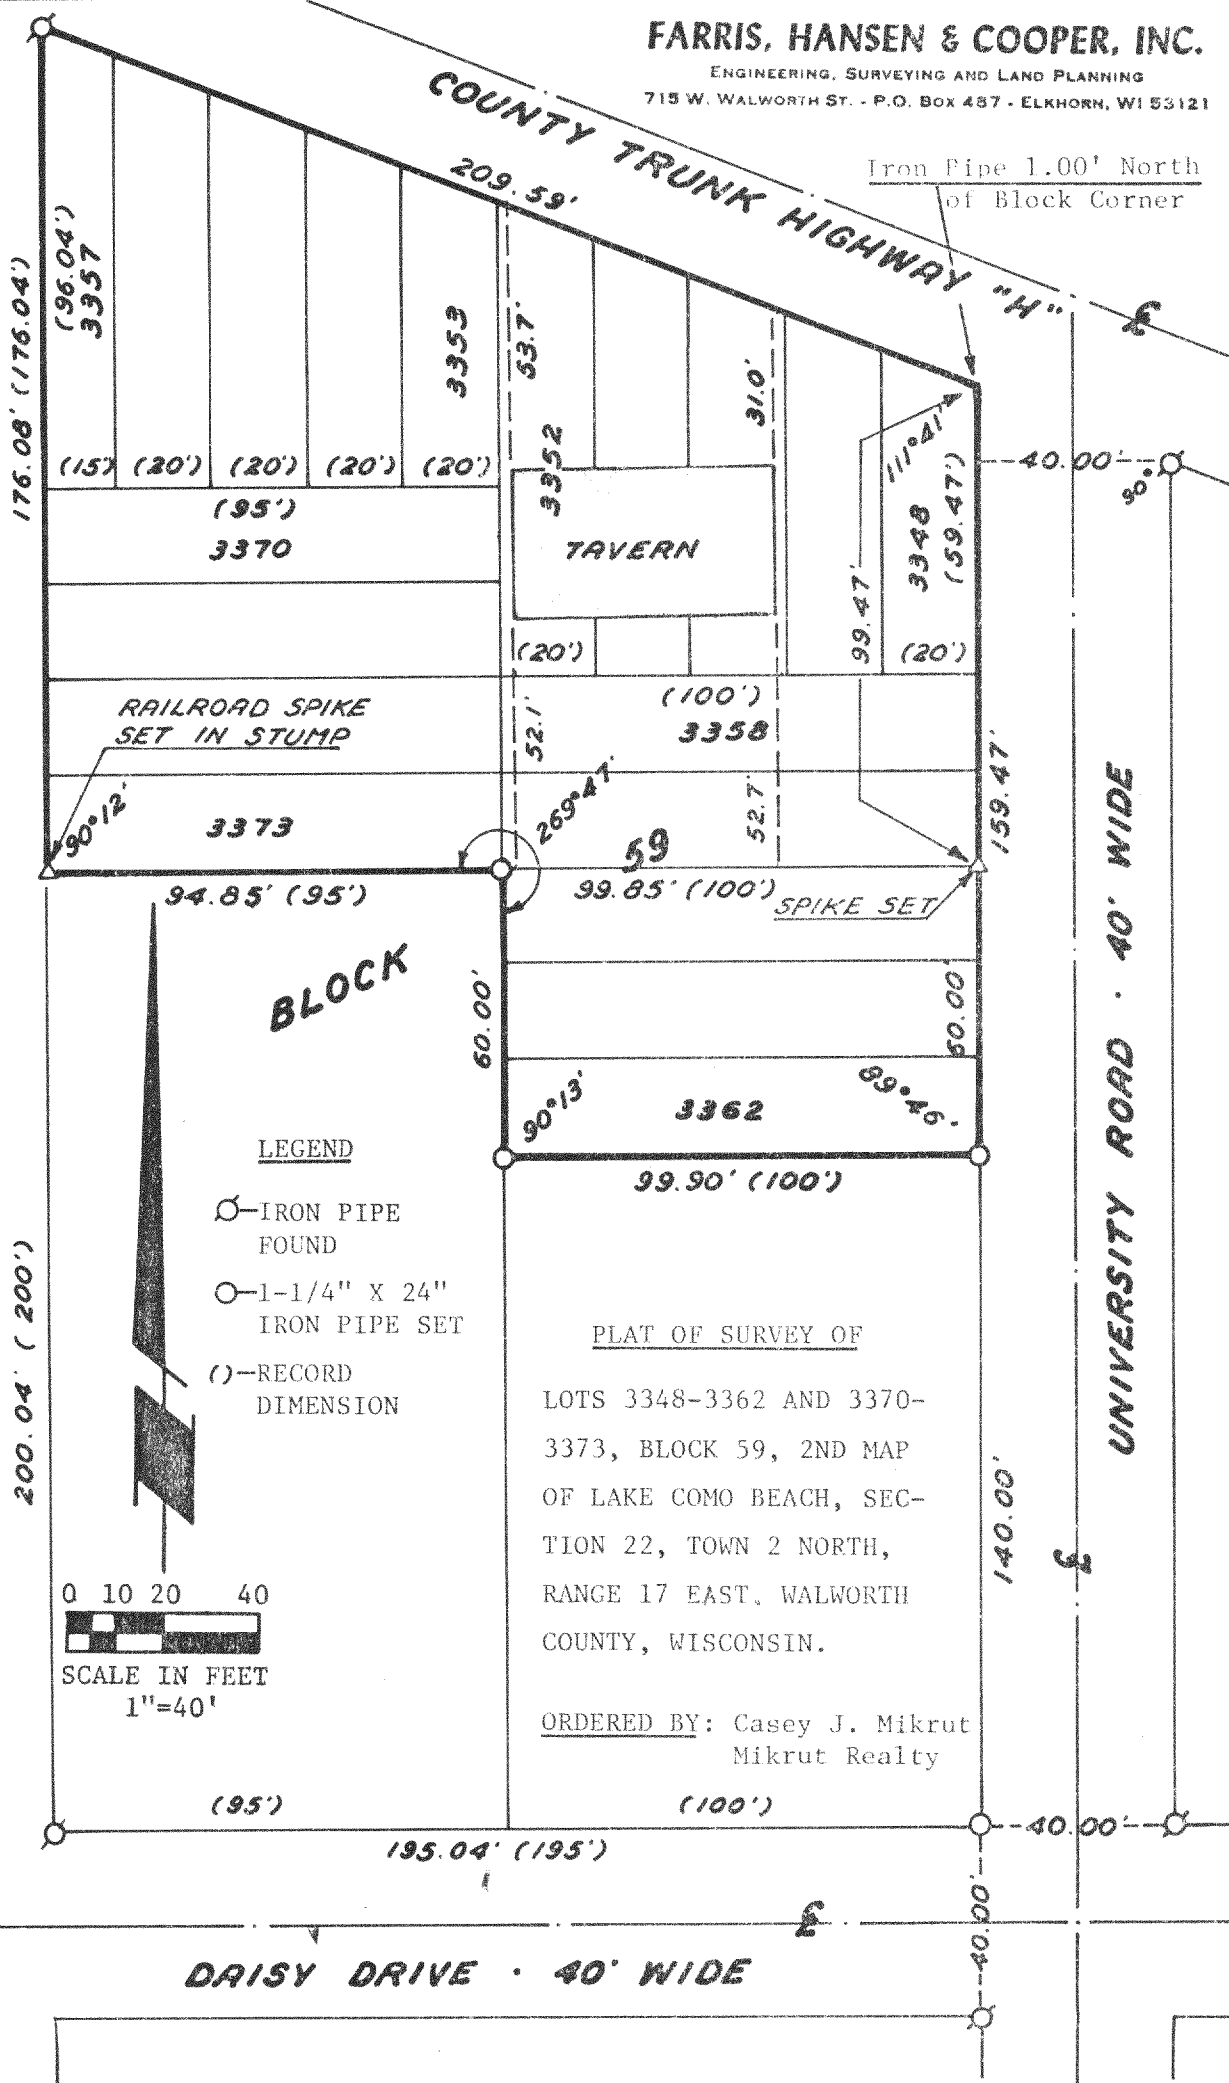

LEGEND


- IRON PIPE FOUND
- 1-1/4" X 24" IRON PIPE SET
- ()-RECORD DIMENSION

0 10 20 40
SCALE IN FEET
1"=40'

PLAT OF SURVEY OF

LOTS 3348-3362 AND 3370-3373, BLOCK 59, 2ND MAP OF LAKE COMO BEACH, SECTION 22, TOWN 2 NORTH, RANGE 17 EAST, WALWORTH COUNTY, WISCONSIN.

ORDERED BY: Casey J. Mikrut
Mikrut Realty

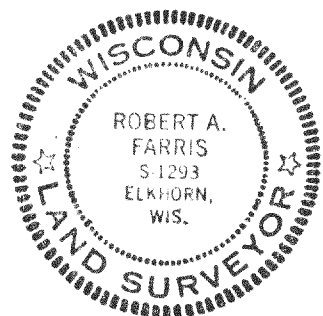

I HEREBY CERTIFY that I have surveyed the property described hereon and that this Plat of Survey is a true and accurate representation of the lot lines and the buildings thereon to the best of my professional knowledge and belief.

Robert A. Farris

Robert A. Farris, Wis. Reg. Surveyor, S-1293
Dated this 23 day of MAY, 1979.

PROJ. NO. 1521

JLKB-618

217-435