



X:\PROJECTS\3269\CONDO_11\UNIT_15\ACAD\3269-11-15-18.DWG

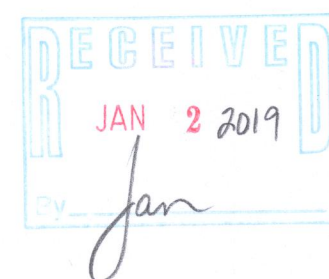

PLAT OF SURVEY UNIT 11-15 OF GENEVA NATIONAL CONDOMINIUM NO. 11

LOCATED IN PART OF THE SE 1/4 OF THE NE 1/4
OF SECTION 30, TOWN 2 NORTH, RANGE 17 EAST,
TOWN OF GENEVA, WALWORTH COUNTY, WISCONSIN

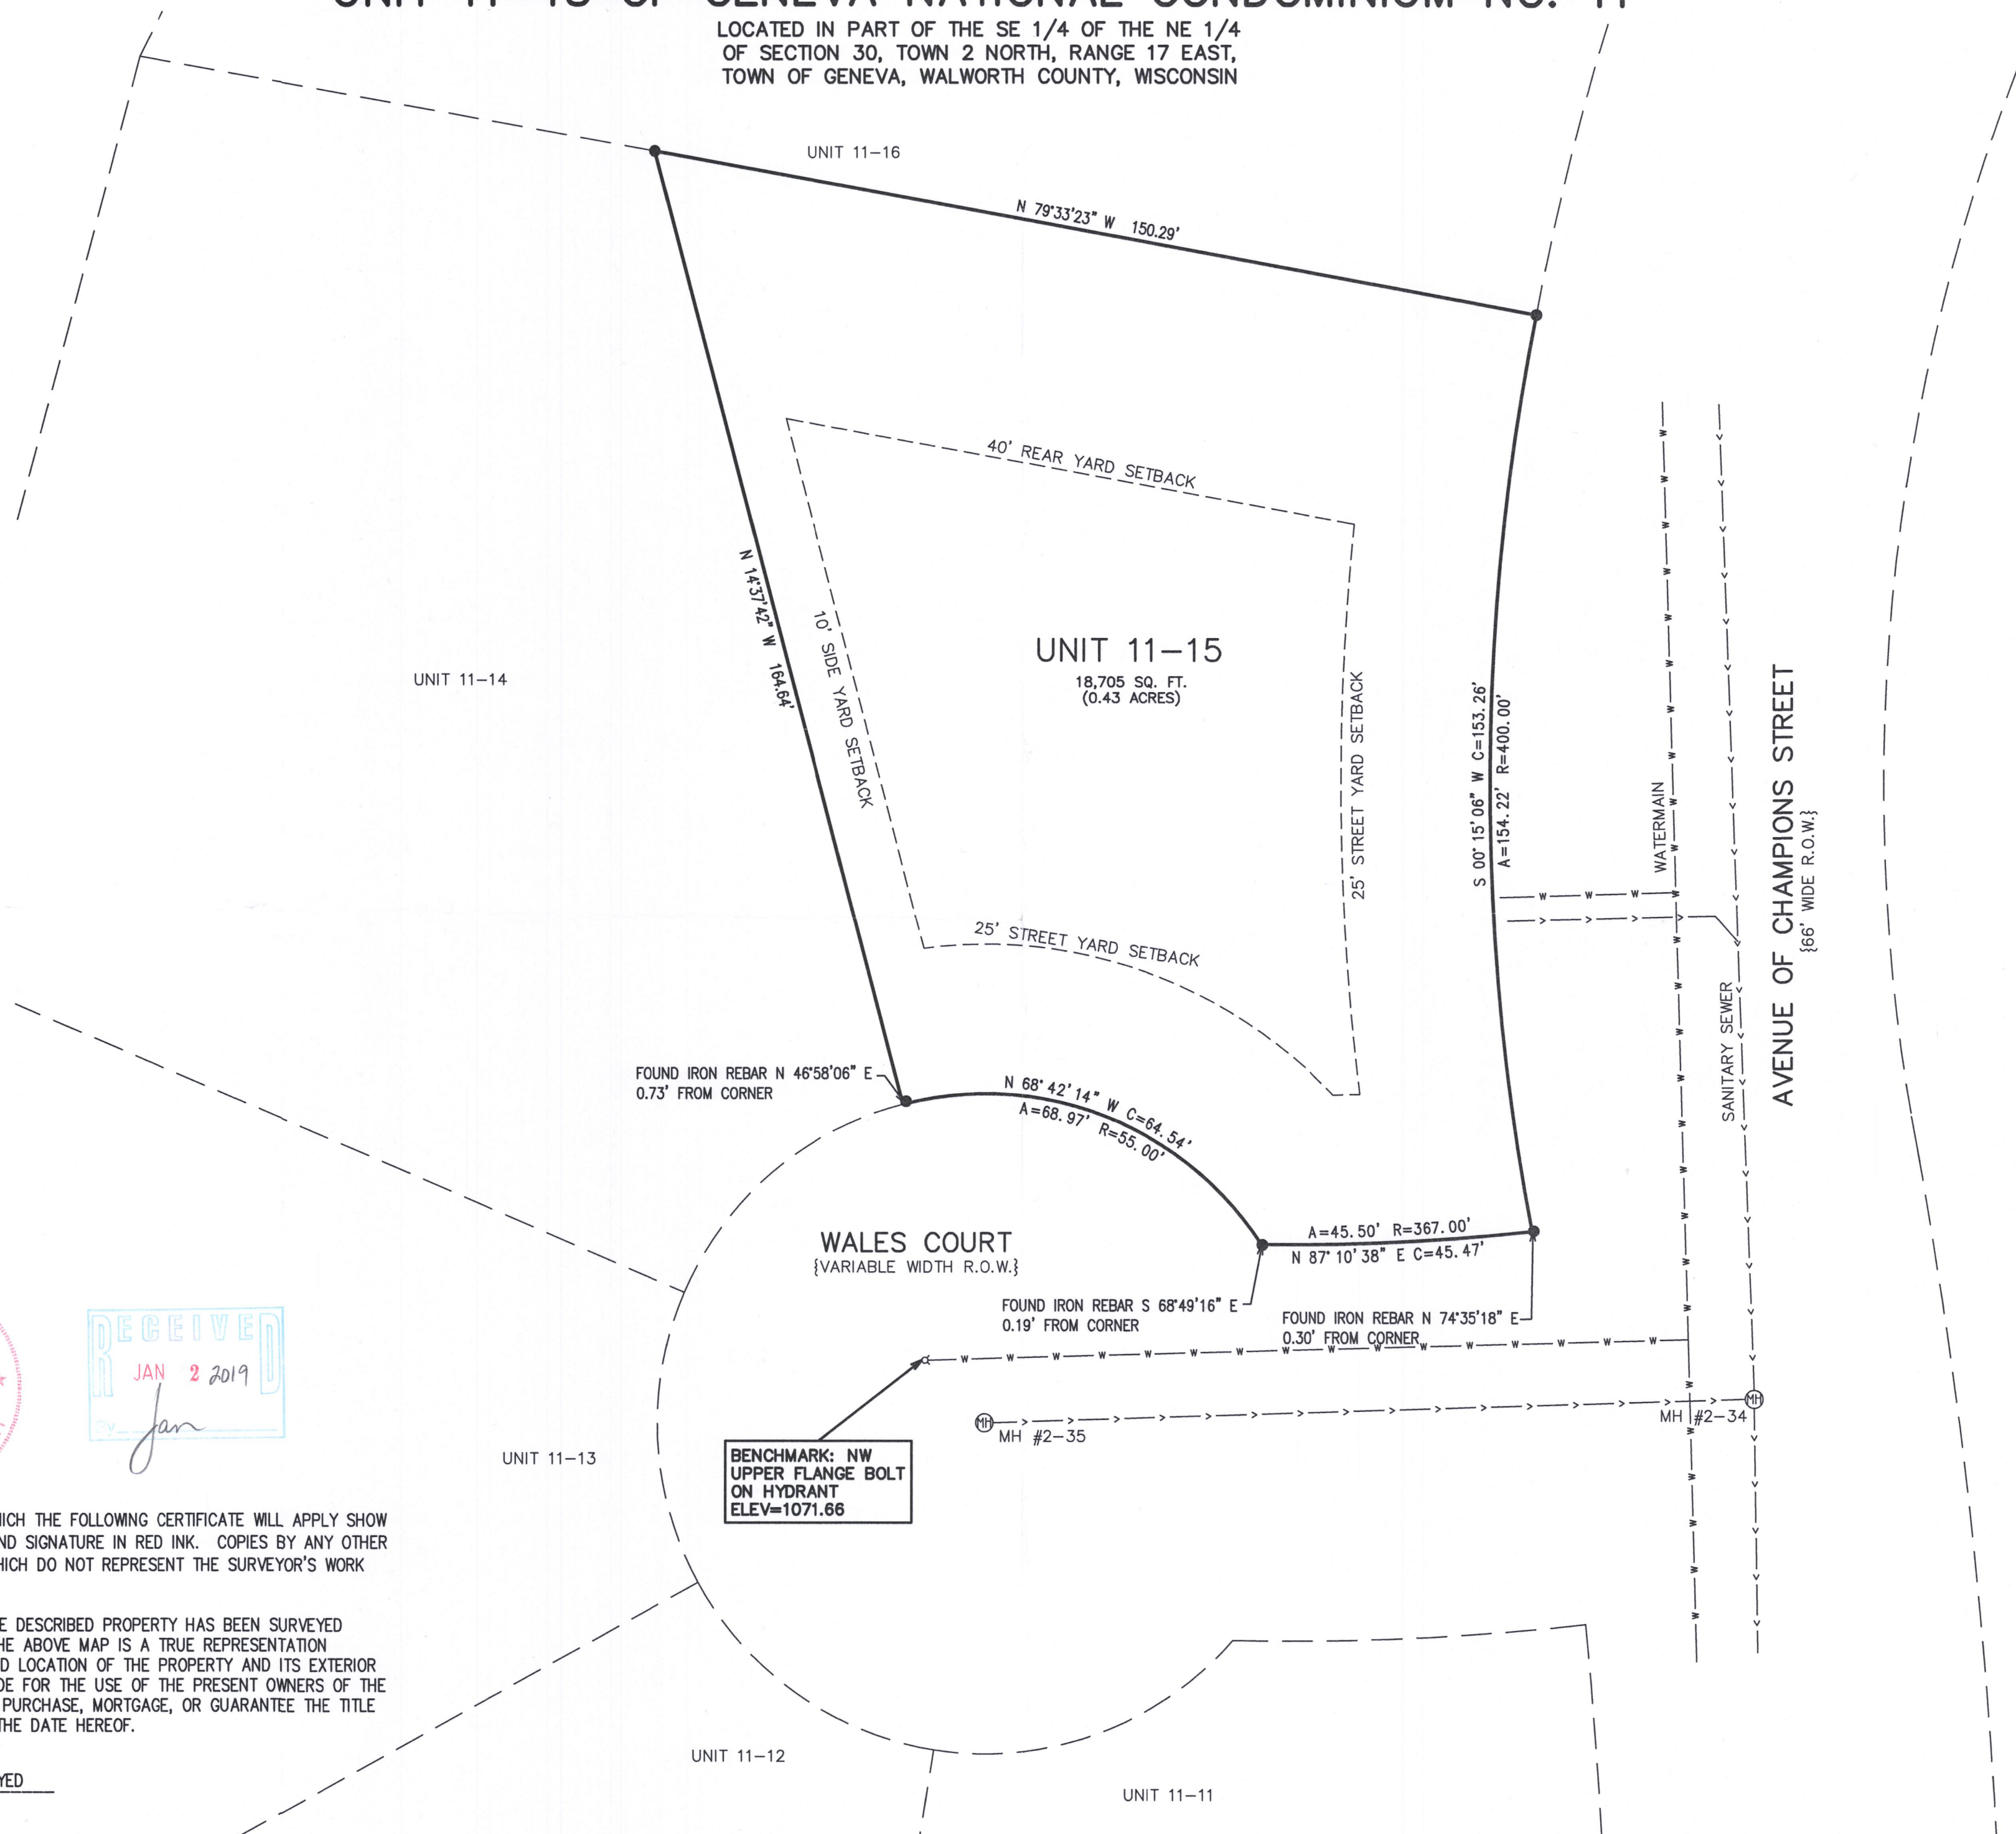

NOTE: COPIES OF THIS MAP TO WHICH THE FOLLOWING CERTIFICATE WILL APPLY SHOW
THE SURVEYOR'S ORIGINAL SEAL AND SIGNATURE IN RED INK. COPIES BY ANY OTHER
MEANS MAY HAVE ALTERATIONS WHICH DO NOT REPRESENT THE SURVEYOR'S WORK
PRODUCT.

I HEREBY CERTIFY THAT THE ABOVE DESCRIBED PROPERTY HAS BEEN SURVEYED
UNDER MY DIRECTION AND THAT THE ABOVE MAP IS A TRUE REPRESENTATION
THEREOF AND SHOWS THE SIZE AND LOCATION OF THE PROPERTY AND ITS EXTERIOR
BOUNDARIES. THIS SURVEY IS MADE FOR THE USE OF THE PRESENT OWNERS OF THE
PROPERTY, AND ALSO THOSE WHO PURCHASE, MORTGAGE, OR GUARANTEE THE TITLE
THERE TO WITHIN ONE YEAR FROM THE DATE HEREOF.

DATED: 12/03/2018 - RESURVEYED

B. Carlson
BRIAN M. CARLSON P.L.S. 2039



PLAT OF SURVEY
UNIT 11-15 GENEVA NATIONAL
LAKE GENEVA, WI 53147

WORK ORDERED BY -
SHOREWEST
830 E. GENEVA STREET
DELAVER, WI 53115

FARRIS, HANSEN & ASSOCIATES, INC.
ENGINEERING - ARCHITECTURE - SURVEYING
7 RIDGWAY COURT P.O. BOX 437
ELKHORN, WISCONSIN 53121
OFFICE: (262) 723-2098 FAX: (262) 723-5886

REVISIONS

PROJECT NO.
3269-11-15-18
DATE:
08/21/1991
SHEET NO.
1 OF 1

JGN 11-15 217-4524