

# Plat of Survey

of

## Lot 1 of Certified Survey Map No. 1814,

recorded in Vol. 8 of Certified Survey Maps of Walworth County on Page 295 and located in the Northwest 1/4 of the Southwest 1/4 of Section 21, Town 2 North, Range 17 East, Town of Geneva, Walworth County, Wisconsin.

Surveyed for: **Keefe Real Estate, Inc.**

751 Geneva Parkway  
Lake Geneva, Wisconsin. 53147




Bearings referenced to the North line of the Southwest 1/4 of Section 21-2-17, recorded as N88°47'18"E in the Wisconsin State Plane Coordinate System, South Zone, (NAD-27).

Tax Parcel  
JG 2100006

### Notes:

The location of paved or gravel surfaces shown on this plat are approximate due to existing snow cover on the property at the time of the field survey.

There may be additional improvements or encroachments on the property which were not visible at the time of the field survey and are not shown on this plat.

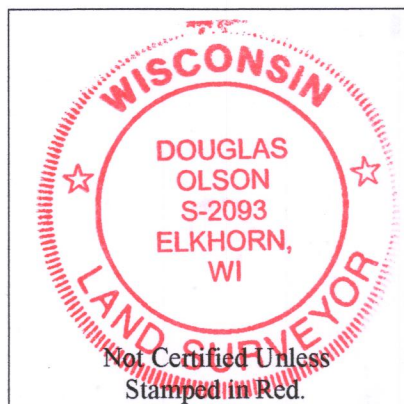

- 1) This Plat of Survey is not certified unless signed and sealed in red ink.
- 2) This survey is subject to Wisconsin lien laws. This Plat of Survey is the notice of intent to file lien. Lien waiver required.
- 3) The Survey Date shown on this Plat of Survey is the completion date of the field work.



Copyright© 2019 by Olson Land Surveying, LLC.

All rights reserved. No part of this survey plat may be reproduced or transmitted in any form by any means - graphic, electronic, or mechanical, including photocopying, tracing, or information storage and retrieval systems - without permission in writing from Douglas G. Olson, Olson Land Surveying, LLC.

I hereby certify that I have surveyed the above described property in compliance with Chapter A-E 7 of the Wisconsin Administrative Code and that the map hereon is correct to the best of my professional knowledge and belief and shows the size and location of the property, its exterior boundaries, the location and dimensions of all visible structures thereon, boundary fences, apparent easements and roadways and visible encroachments, if any.

This survey is made for the exclusive use of the present owners of the property, and also those who purchase, mortgage or guarantee title thereto, within one year from the date hereof.

Douglas G. Olson  
Wisconsin Professional Land Surveyor - 2093

Palmer Road

recorded as(N88°47'18"E 275.00')  
N88°47'18"E 275.00'

(1309.15')LLJ 1969  
1308.92'

Center 1/4 Corner  
Section 21-2-17  
N. 229,372.31  
E. 2,405,905.95

West 1/4 Corner  
Section 21-2-17  
N. 229,316.70  
E. 2,403,276.76

recorded as(N88°47'18"E 2629.85')State Plane  
N88°47'18"E 2629.85'  
North line of the Southwest 1/4 of Section 21-2-17.

1045.93'  
(1045.93')

33.00'

(66' Wide)

(N89°52'40"E 275.00')  
N88°47'18"E 274.99'

28.00'

Tree at corner.

56.5'

60.6'

34.4'

12.3'

20.5'

34.3'

15.9'

13.4'

15.8'

15.8'

12.3'

20.5'

34.3'

15.9'

13.4'

15.8'

15.8'

12.3'

20.5'

34.3'

15.9'

13.4'

15.8'

15.8'

12.3'

20.5'

34.3'

15.9'

13.4'

15.8'

15.8'

12.3'

20.5'

34.3'

15.9'

13.4'

15.8'

15.8'

12.3'

20.5'

34.3'

15.9'

13.4'

15.8'

15.8'

12.3'

20.5'

34.3'

15.9'

13.4'

15.8'

15.8'

1