
LAND-MARK SURVEYING Mark L. Miritz

Wisconsin Professional Land Surveyor S-2582

N9330 Knuteson Drive Whitewater, WI 53190 Phone:(262)495-3284 MARKMIRITZ@ LAND-MARKSURVEYING.COM

ORDERED BY: EGERT LAW, S.C. 835 GENEVA PARKWAY NORTH, SUITE 1 LAKE GENEVA, WI 53147



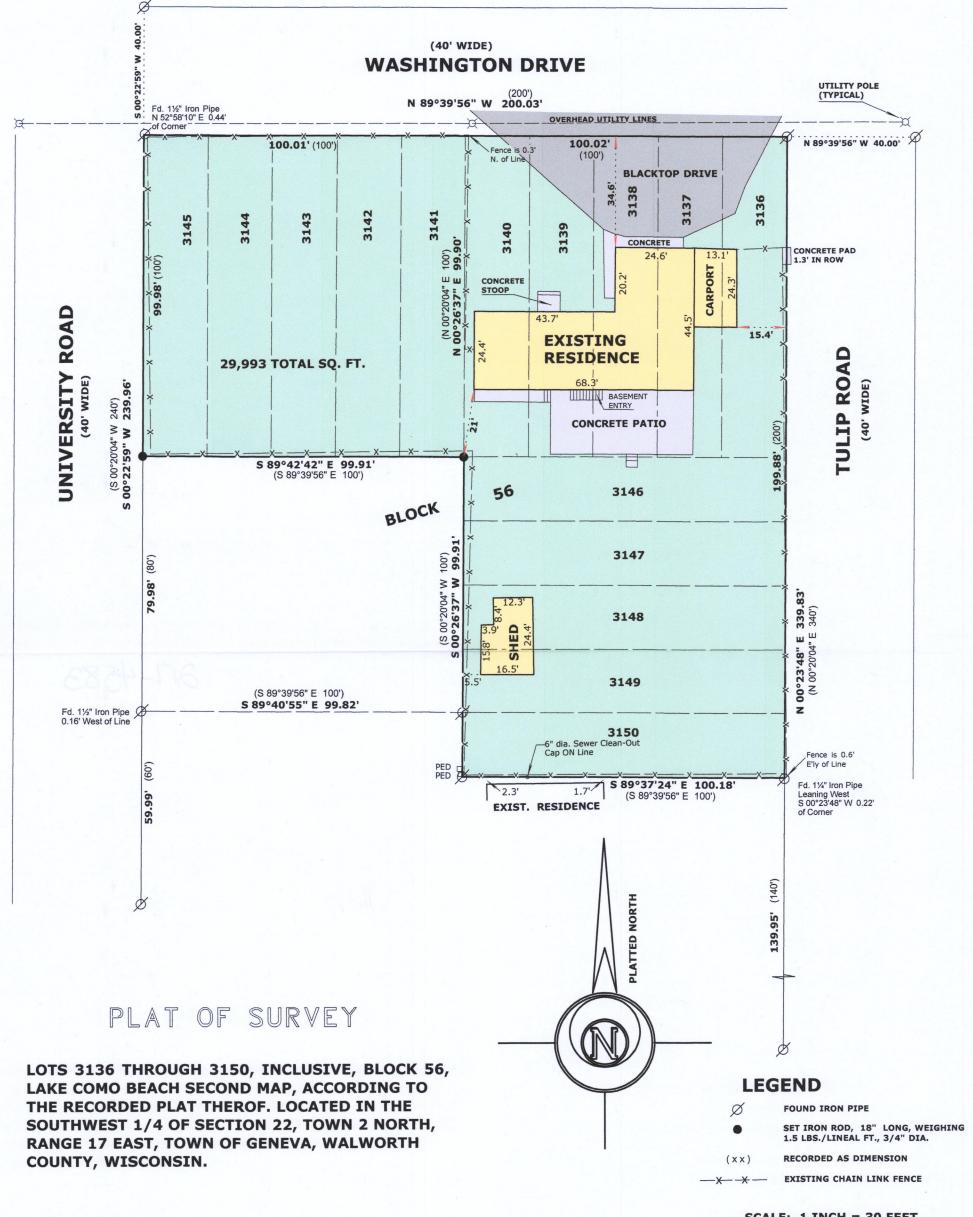



SCALE: 1 INCH = 30 FEET

"I hereby certify that the above described property has been surveyed by me or under my direction and that the above map is a true representation thereof and shows the size and location of the property, its exterior boundaries, the location of all visible structures and dimensions of all principal buildings thereon, boundary fences, apparent

principal buildings thereon, boundary fences, apparent easements, roadways and visible encroachments, if any."

"This survey is made for the use of the present owners of the property, and also those who purchase, mortgage, or guarantee the title thereto within one year from date hereof."

Mark L. MIRITZ
WISCONSIN PROFESSIONAL

LAND SURVEYOR S-2582

DATE: JULY 12, 2019 JOB NO. 19.704

JLCB-568

217-4583