

# LAND-MARK SURVEYING

Mark L. Miritz  
Wisconsin Professional Land Surveyor S-2582


N9330 Knuteson Drive  
Whitewater, WI 53190  
Phone: (262) 495-3284  
MARKMIRITZ@  
LAND-MARKSURVEYING.COM

## PLAT OF SURVEY

### LEGAL DESCRIPTION:

LOCATED IN THE SOUTHEAST 1/4 OF THE NORTHWEST 1/4, SECTION 26,  
TOWNSHIP 2 NORTH, RANGE 17 EAST, IN THE TOWN OF GENEVA, WALWORTH  
COUNTY, WISCONSIN

LOT 1, BLOCK 2, HAWTHORNE HILLS SUBDIVISION

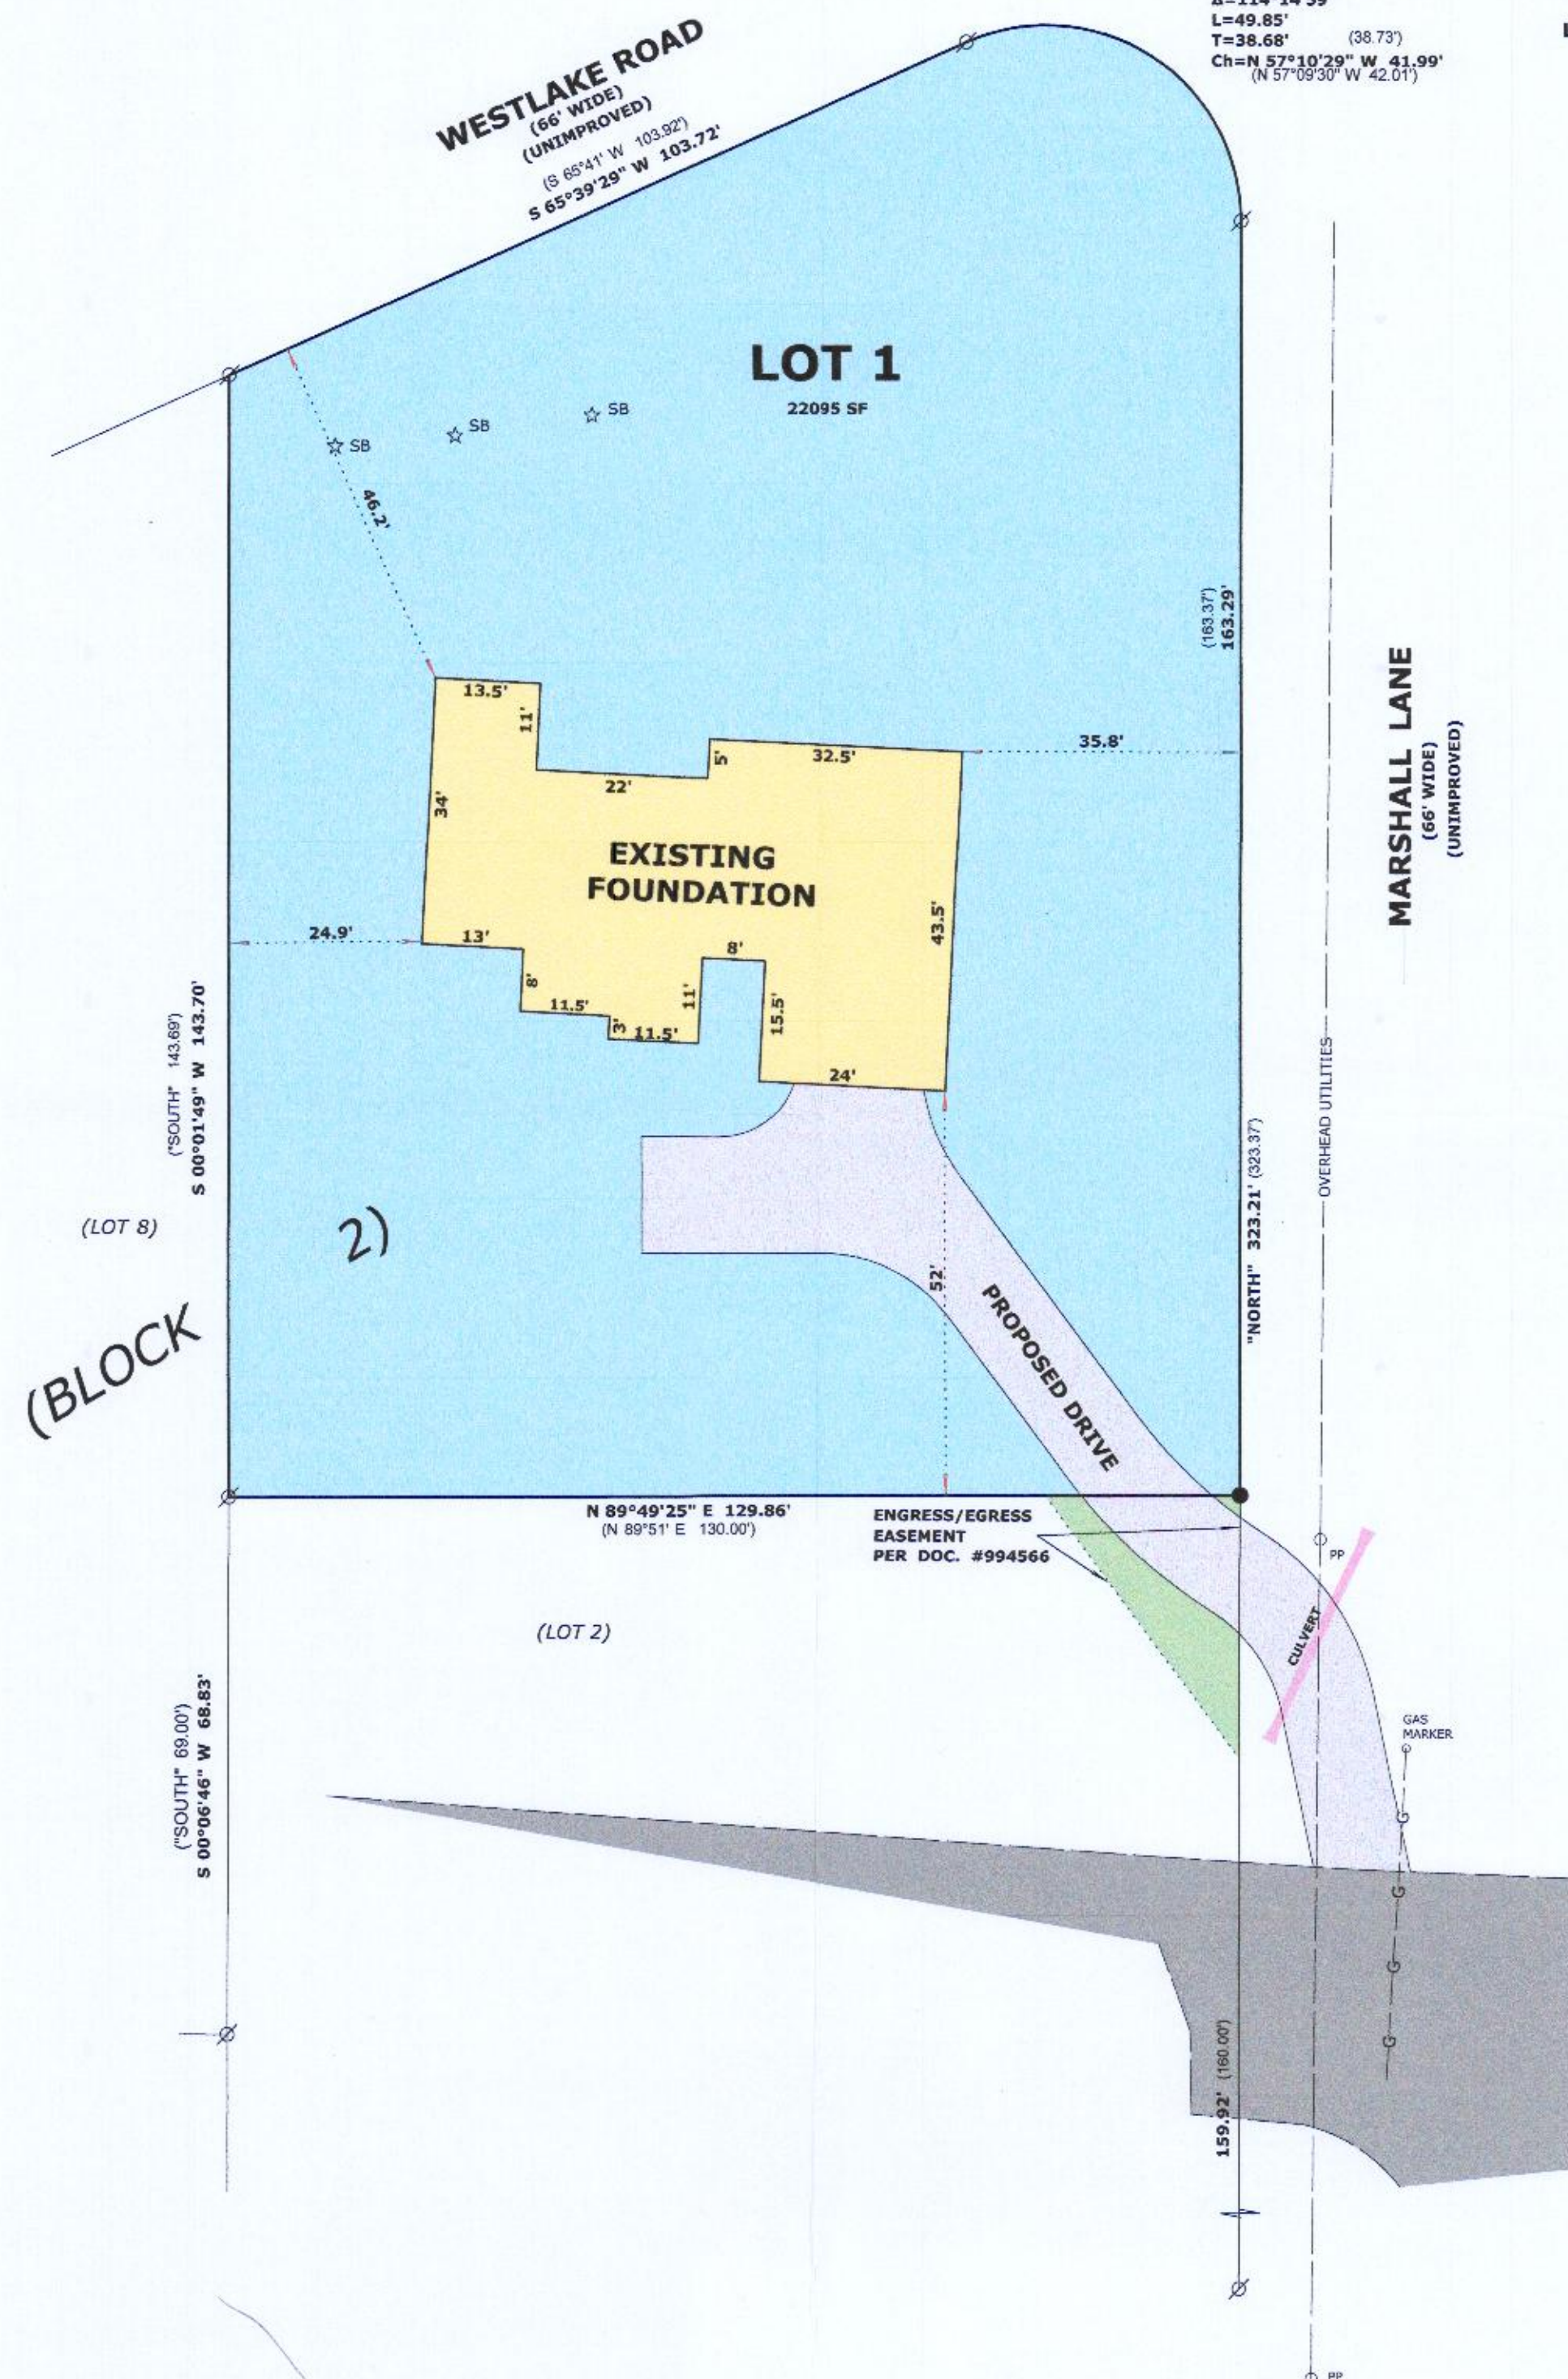

REVISED DEC. 23, 2019 TO SHOW  
FOUNDATION "AS BUILT"

DATE: September 12, 2019 JOB NO. 19.812

JHH-9

217-4638