
PLATOF SURVEY OF


HEREON RELATE TO THE SOUTH LOCK 133 OF LAKE COMO DIVISION. ASSUMED BEARING 89°39'56" EAST AS PLATTED.

LOTS 7847-7851 IN BLOCK 134 OF "LAKE COMO BEACH", ACCORDING TO THE RECORDED PLAT THEREOF. SAID LAND BEING IN THE TOWN OF GENEVA, COUNTY OF WALWORTH AND STATE OF WISCONSIN.

SURVEY FOR: ANTHONY SQUEO

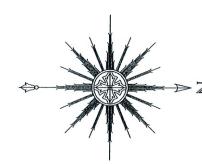

NOTE: REFER TO A CURRENT TITLE REPORT FOR EASEMENTS, RESTRICTIONS OR COVENANTS WHICH MAY AFFECT THIS PROPERTY.

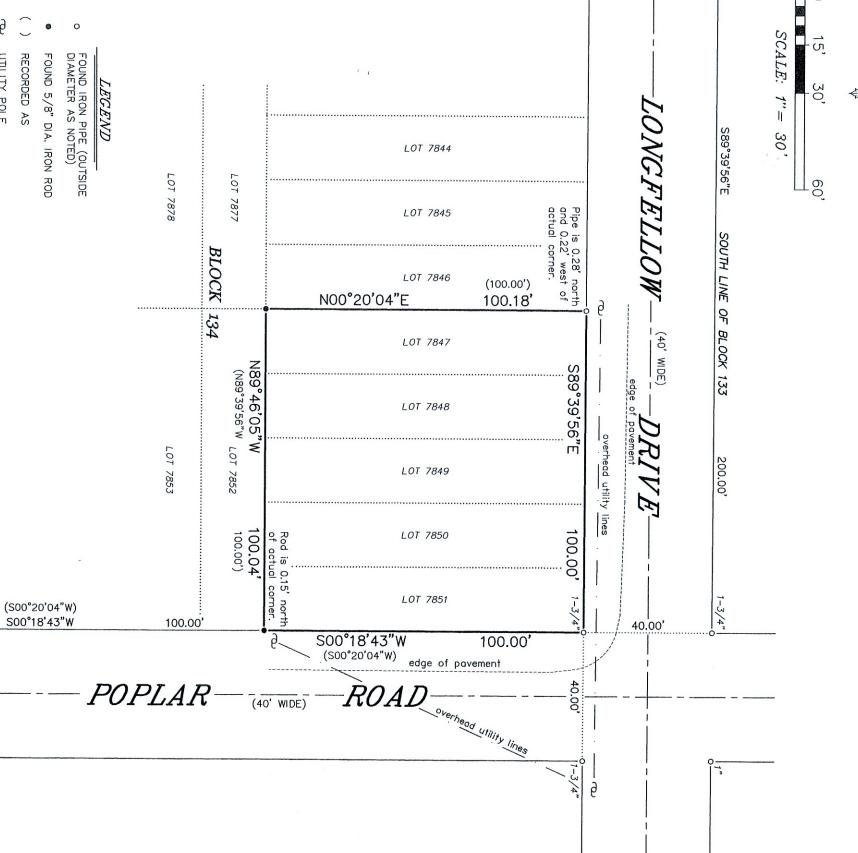

- FOUND IRON PIPE (OUTSIDE DIAMETER AS NOTED)
- FOUND 5/8" DIA. IRON ROD
- RECORDED AS
- UTILLITY POLE

S SURVEY IS MADE FOR THE USE OF THE PRESENT ERS OF THE PROPERTY, AND THOSE WHO PURCHASE, TGAGE, OR GUARANTEE THE TITLE THERETO WITHIN ONE R FROM DATE HEREOF."

EREBY CERTIFY THAT I HAVE SURVEYED THE ABOVE CRIBED PROPERTY AND THAT THE ABOVE MAP IS A RECT REPRESENTATION THEREOF AND SHOWS THE SIZE LOCATION OF THE PROPERTY, ITS EXTERIOR NDARRES, THE LOCATION OF ALL VISIBLE STRUCTURES DIMENSIONS OF ALL PRINCIPAL BUILDINGS THEREON, NDARY FENCES, APPARENT EASEMENTS, ROADWAYS AND ROACHMENTS, IF ANY."

SATTER SURVEYING, LLC
LAND SURVEYS, MAPPING AND PLANNING
272 ORIGEN STREET
BURLINGTON, WI 53105
262-661-4239

THIS IS NOT AN ORIGINAL PRINT UNLESS THIS SEAL IS RED.

URVE

121807 JOB NUMBER

JULY 24, 2020 DATE