

# PLAT OF SURVEY

A PARCEL OF LAND LOCATED IN THE NORTHEAST 1/4 OF THE NORTHEAST 1/4 OF SECTION 30 IN TOWNSHIP 2 NORTH, RANGE 17 EAST, IN THE TOWN OF GENEVA, WALWORTH COUNTY, WISCONSIN.

## LEGEND

- FOUND IRON ROD
- ( XX ) RECORDED AS
- EXISTING CONCRETE
- EXISTING ASPHALT DRIVE
- EXISTING BUILDING
- TRANSFORMER
- UTILITY PEDESTAL



0 30 60 Feet

SCALE: 1"=30'

## NOTE:

1. BASIS OF BEARING: THE WISCONSIN STATE PLANE COORDINATE SYSTEM, NAD-83, SOUTH ZONE.
2. FIELD WORK COMPLETED JANUARY 7, 2020
3. BUILDING SURVEYED TO THE EXTERIOR OF SIDING.
4. FIELD CREW CHIEF: LOGAN RANDLE

## LEGAL DESCRIPTION:

A PARCEL OF LAND LOCATED IN THE NORTHEAST 1/4 OF THE NORTHEAST 1/4 OF SECTION 30 IN TOWNSHIP 2 NORTH, RANGE 17 EAST, IN THE TOWN OF GENEVA, WALWORTH COUNTY, WISCONSIN, MORE PARTICULARLY DESCRIBED AS:

UNIT 11-16 IN GENEVA NATIONAL CONDOMINIUM NO. 11, AS RECORDED IN DOC # 194629 AT THE WALWORTH COUNTY REGISTER OF DEEDS.

## SURVEY ORDERED BY:


CHRIS HUMPHREYS

## PROPERTY ADDRESS:

1760 AVENUE OF CHAMPIONS  
LAKE GENEVA, WI 53147

## SURVEYOR:


PAUL H. VAN HENKELUM, PLS  
CARDINAL ENGINEERING LLC

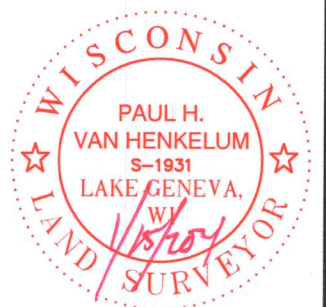

"I HEREBY CERTIFY THAT I HAVE SURVEYED THE ABOVE DESCRIBED PROPERTY AND THE MAP IS A TRUE AND CORRECT REPRESENTATION OF ITS EXTERIOR BOUNDARIES AND SHOWS THE SIZE AND LOCATION OF ALL VISIBLE STRUCTURES, APPARENT EASEMENTS AND ENCROACHMENTS, IF ANY."

*Paul H. Van Henkelum*  
PAUL H VAN HENKELUM, PLS #1931

*1/15/2021*  
DATE

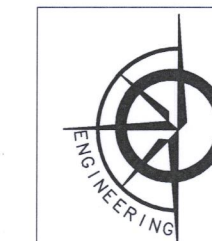

CARDINAL ENGINEERING LLC  
DESIGNING IN TRUE DIRECTIONS

PO BOX 281 - 1200 LA SALLE ST.  
LAKE GENEVA, WI 53147  
262-757-8776  
CARDINALENGINEERINGWI.COM

DATE: 1/15/2021 JOB No. 20541  
SHEET 1 OF 1 JBM

GOLF CLUB GROUNDS

(N26° 28' 52"E 123.83')  
N26° 20' 52"E 123.68'

UNIT 11-16  
GENEVA NATIONAL  
CONDO.


UNIT 11-17  
GENEVA NATIONAL  
CONDO.

EXISTING  
BUILDING

UNIT 11-14  
GENEVA NATIONAL  
CONDO.

UNIT 11-15  
GENEVA NATIONAL  
CONDO.

AVENUE OF CHAMPIONS 66' R/W

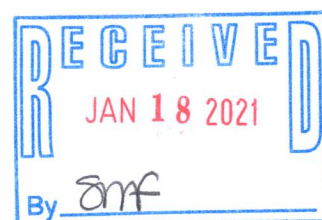

JGN 11-16

217-479