

Parcel # JLCB 02443

Plat of a survey for Jeff Maslinski of Lots 11220 to 11224 & 11249 to 11253, Block 202, Lake Como Beach Fifth Map, a recorded plat in the Town of Geneva, Walworth County, Wisconsin.


Certificate
The above-described property has been surveyed under my direction and the map hereon drawn is a correct representation thereof to the best of my knowledge and belief.

9/3/2020 *Mark R. Madsen*

WISCONSIN
MARK R. MADSEN
S-2271
RACINE, WI
LAND SURVEYOR



Rebar Set 50' West due to Sanitary Lateral installation work.

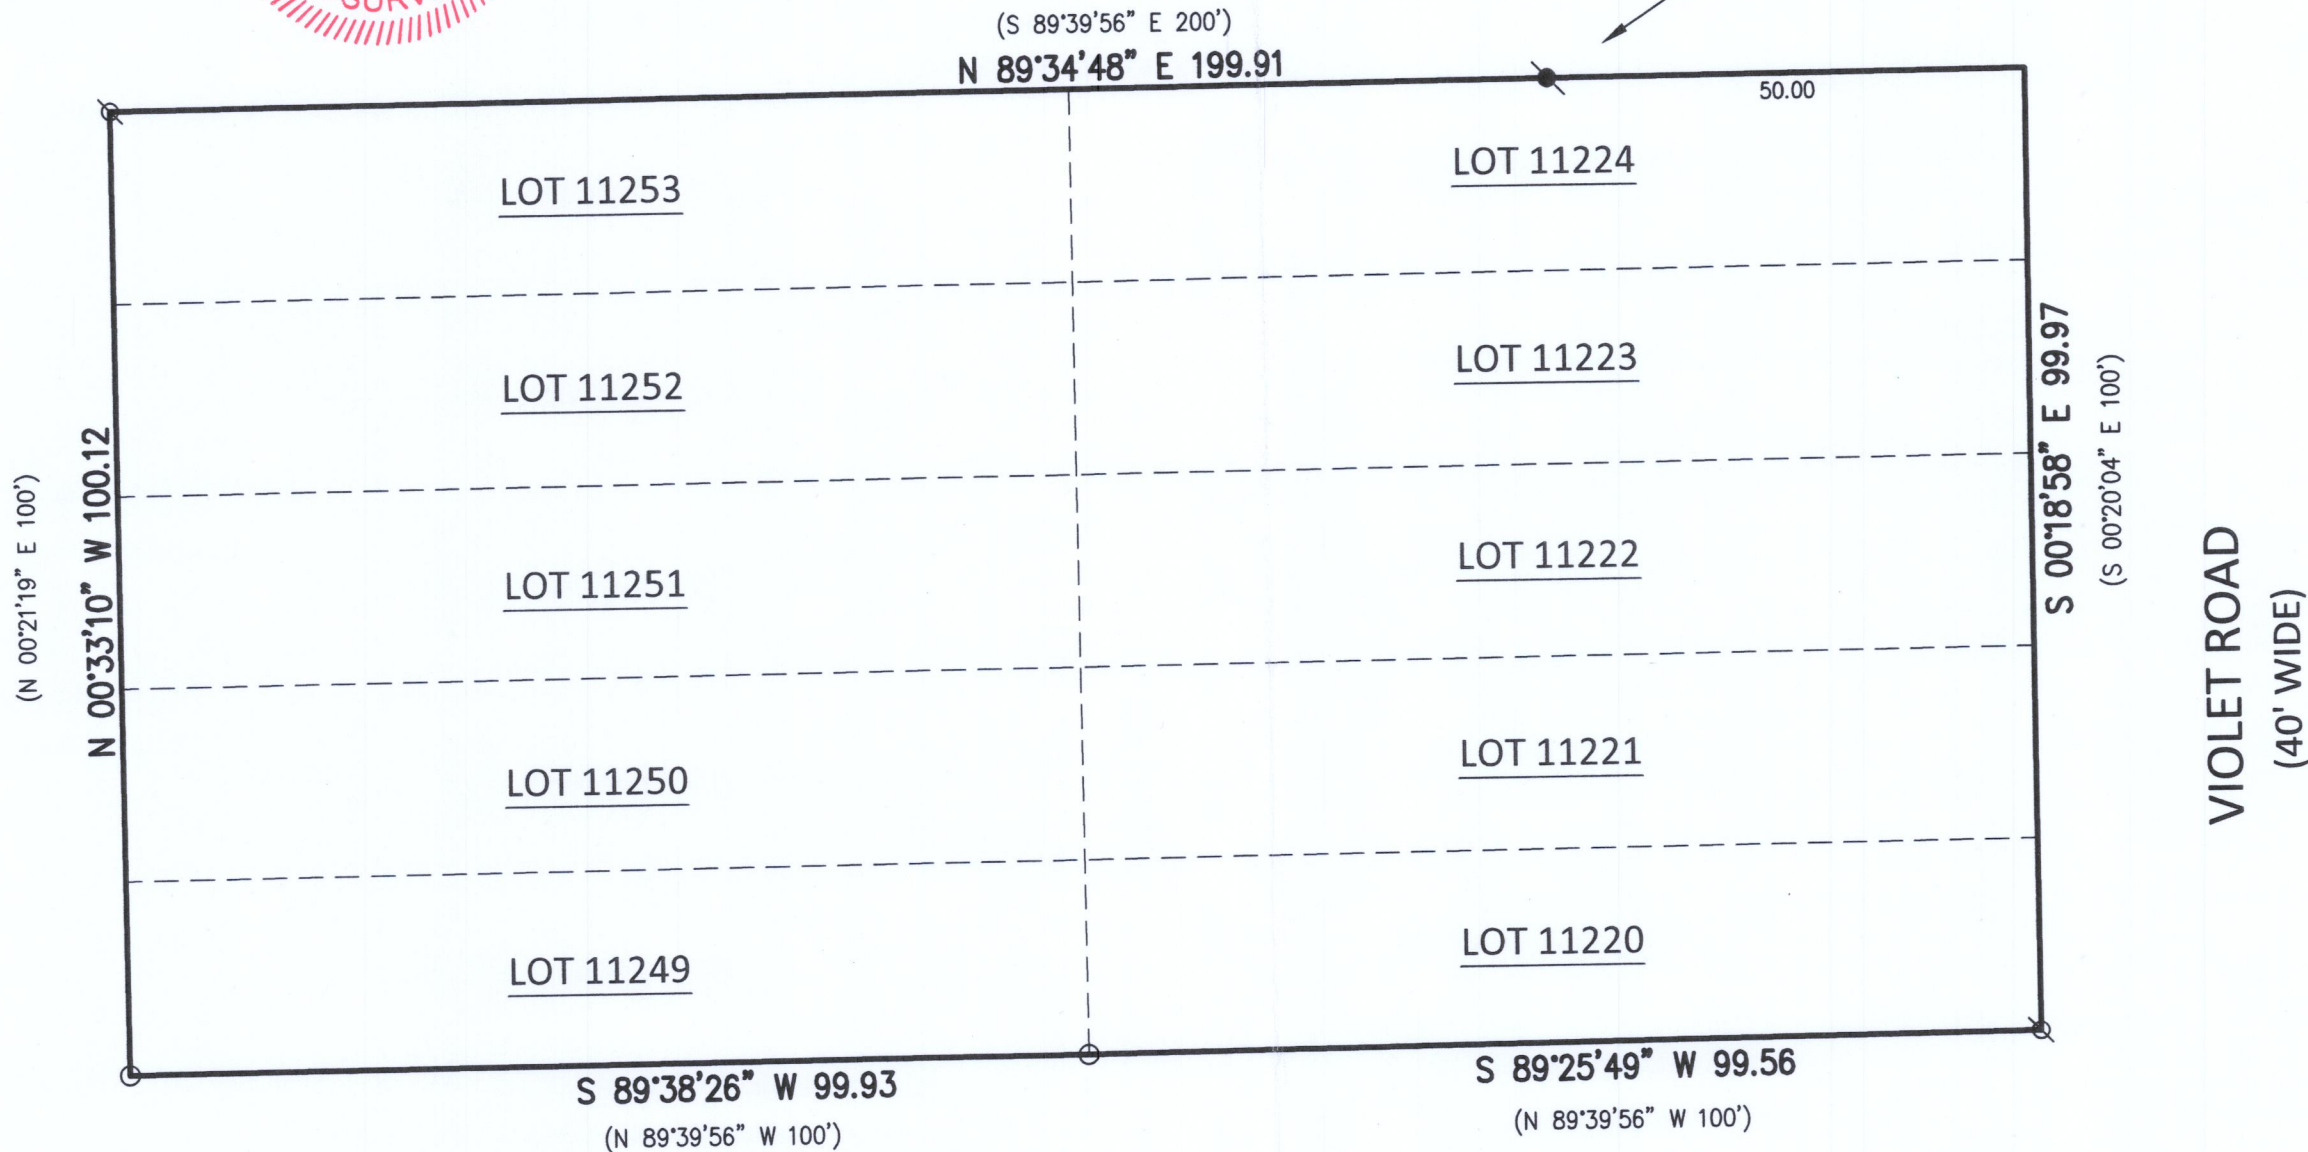


NOTES

BEARING BASE: GRID NORTH, WISCONSIN COORDINATE SYSTEM, SOUTH ZONE. BASED UPON NAD 1983 / 2011

LEGEND

- () RECORDED AS
- FOUND IRON PIPE
- ⊗ FOUND REBAR
- SET 3/4" REBAR

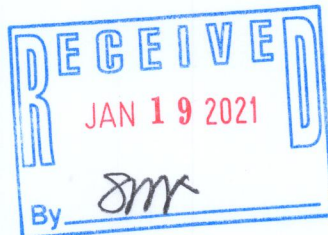

Scale: 1" = 20'
Drawn By: DMB
DATE: 9-2-2020
2020.0193.01

mb
Nielsen Madsen + Barber
CIVIL ENGINEERS AND LAND SURVEYORS
1458 Horizon Blvd. Suite 200, Racine, WI. 53406
Tele: (262)634-5588 Website: www.nmbssc.net

JLCB - 2443

217-4720

7:25:54 AM

Thursday, September 03, 2020