

FOUNDATION AS-BUILT
LOTS 5622-25 FERN ROAD

A PARCEL OF LAND LOCATED IN THE SOUTHWEST 1/4 OF THE NORTHEAST 1/4 OF SECTION 28 IN TOWNSHIP 2 NORTH, RANGE 17 EAST, IN THE TOWN OF GENEVA, WALWORTH COUNTY, WISCONSIN, MORE PARTICULARLY DESCRIBED AS:
LOTS 5622-5625 OF BLOCK 100 OF THE LAKE COMO BEACH SUBDIVISION AS RECORDED IN DOCUMENT #P255830 AS PER THE WALWORTH COUNTY REGISTER OF DEEDS.

CLIENT

FERN ROAD GRADING AND SITE PLAN
TOWN OF GENEVA, WALWORTH COUNTY, WI

SITE AND GRADING PLAN

PRELIMINARY



0 10 20 Feet

SCALE 1" = 10'

22x34 SHEET



LEGEND

	STONE TRACKING PAD
	PROPOSED ASPHALT DRIVEWAY
	EXISTING MANHOLE
	EXISTING WATER VALVE
	EXISTING HYDRANT
	FOUND .5" IRON PIPE
	FOUND IRON ROD
{ XX }	RECORDED AS



CARDINAL ENGINEERING LLC
DESIGNING IN TRUE DIRECTIONS

1200 LA SALLE STREET,
LAKE GENEVA, WI 53147
262-757-8776
CARDINALENGINEERINGWI.COM

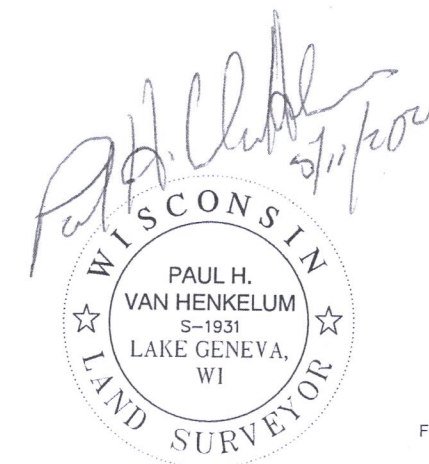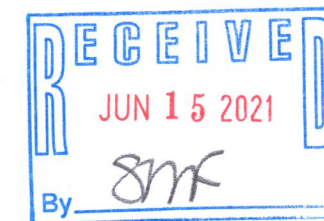

FOUNDATION ASBUILT COMPLETED 05/11/2021

NO.	REVISION DESCRIPTION	REV DATE
SCALE		1 IN=10 FT
PROJECT NUMBER		20477
DATE		03-10-2021
PROJECT MGR		RWC
DRAWN BY		EJO
DESIGNED BY		EJO
SHEET NUMBER		

1 OF 1