

HAROLD H. KOLB

REGISTERED PROFESSIONAL LAND SURVEYOR
LAKE GENEVA, WISCONSIN

OWNER: TOM LAUGHLIN

ACCURACY:

DISTANCES: $\pm 0.01'$

ANGLES: $\pm 05''$

ERROR OF CLOSURE: LESS THAN ONE
PART IN 3,000

PLAT OF SURVEY OF

THE EAST 28.8 FEET OF LOT 71
AND THE WEST 21.2 FEET OF
LOT 20, CONSUMERS COMPANY
SUBDIVISION, AND PART OF THE
NORTHERLY 85 FEET OF THE ABAN-
DONED CHICAGO AND NORTHWESTERN
RAILROAD RIGHT-OF-WAY, SECTION
33, T2N, R17E, WALWORTH COUNTY,
WISCONSIN.


N



SCALE: 1" = 30'

LEGEND

- φ — IRON PIPE FOUND
- — IRON PIPE PLACED
- — CONCRETE MONUMENT
- x — SPIKE
- () — AS DESCRIBED

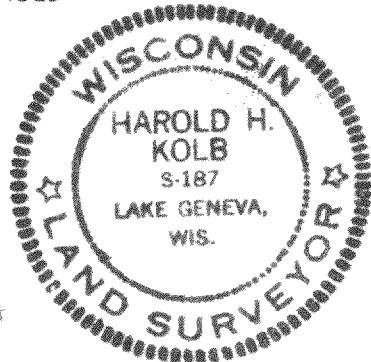

I, HAROLD H. KOLB, DO HEREBY CERTIFY THAT I HAVE
SURVEYED THE PROPERTY HEREON DESCRIBED ACCORDING
TO THE OFFICIAL RECORDS, AND THAT THE PLAT HEREON
IS A CORRECT REPRESENTATION OF THE LOT LINES.

Harold H. Kolb

HAROLD H. KOLB
WISCONSIN REGISTERED LAND SURVEYOR, S-187

DATE May 28, 1976

217-483

JCON-6
11-39A