


PLAT OF SURVEY

- OF -

PREPARED FOR:

DIANNE COSTANZO
MARY KOMPARD

Lots 9608, 9609, 9620, 9621, 9622, 9623, 9624, 9625 and 9626, Block 173, Fourth Map of Lake Como Beach, according to the recorded plat thereof. Said land being in the Town of Geneva, County of Walworth, State of Wisconsin.

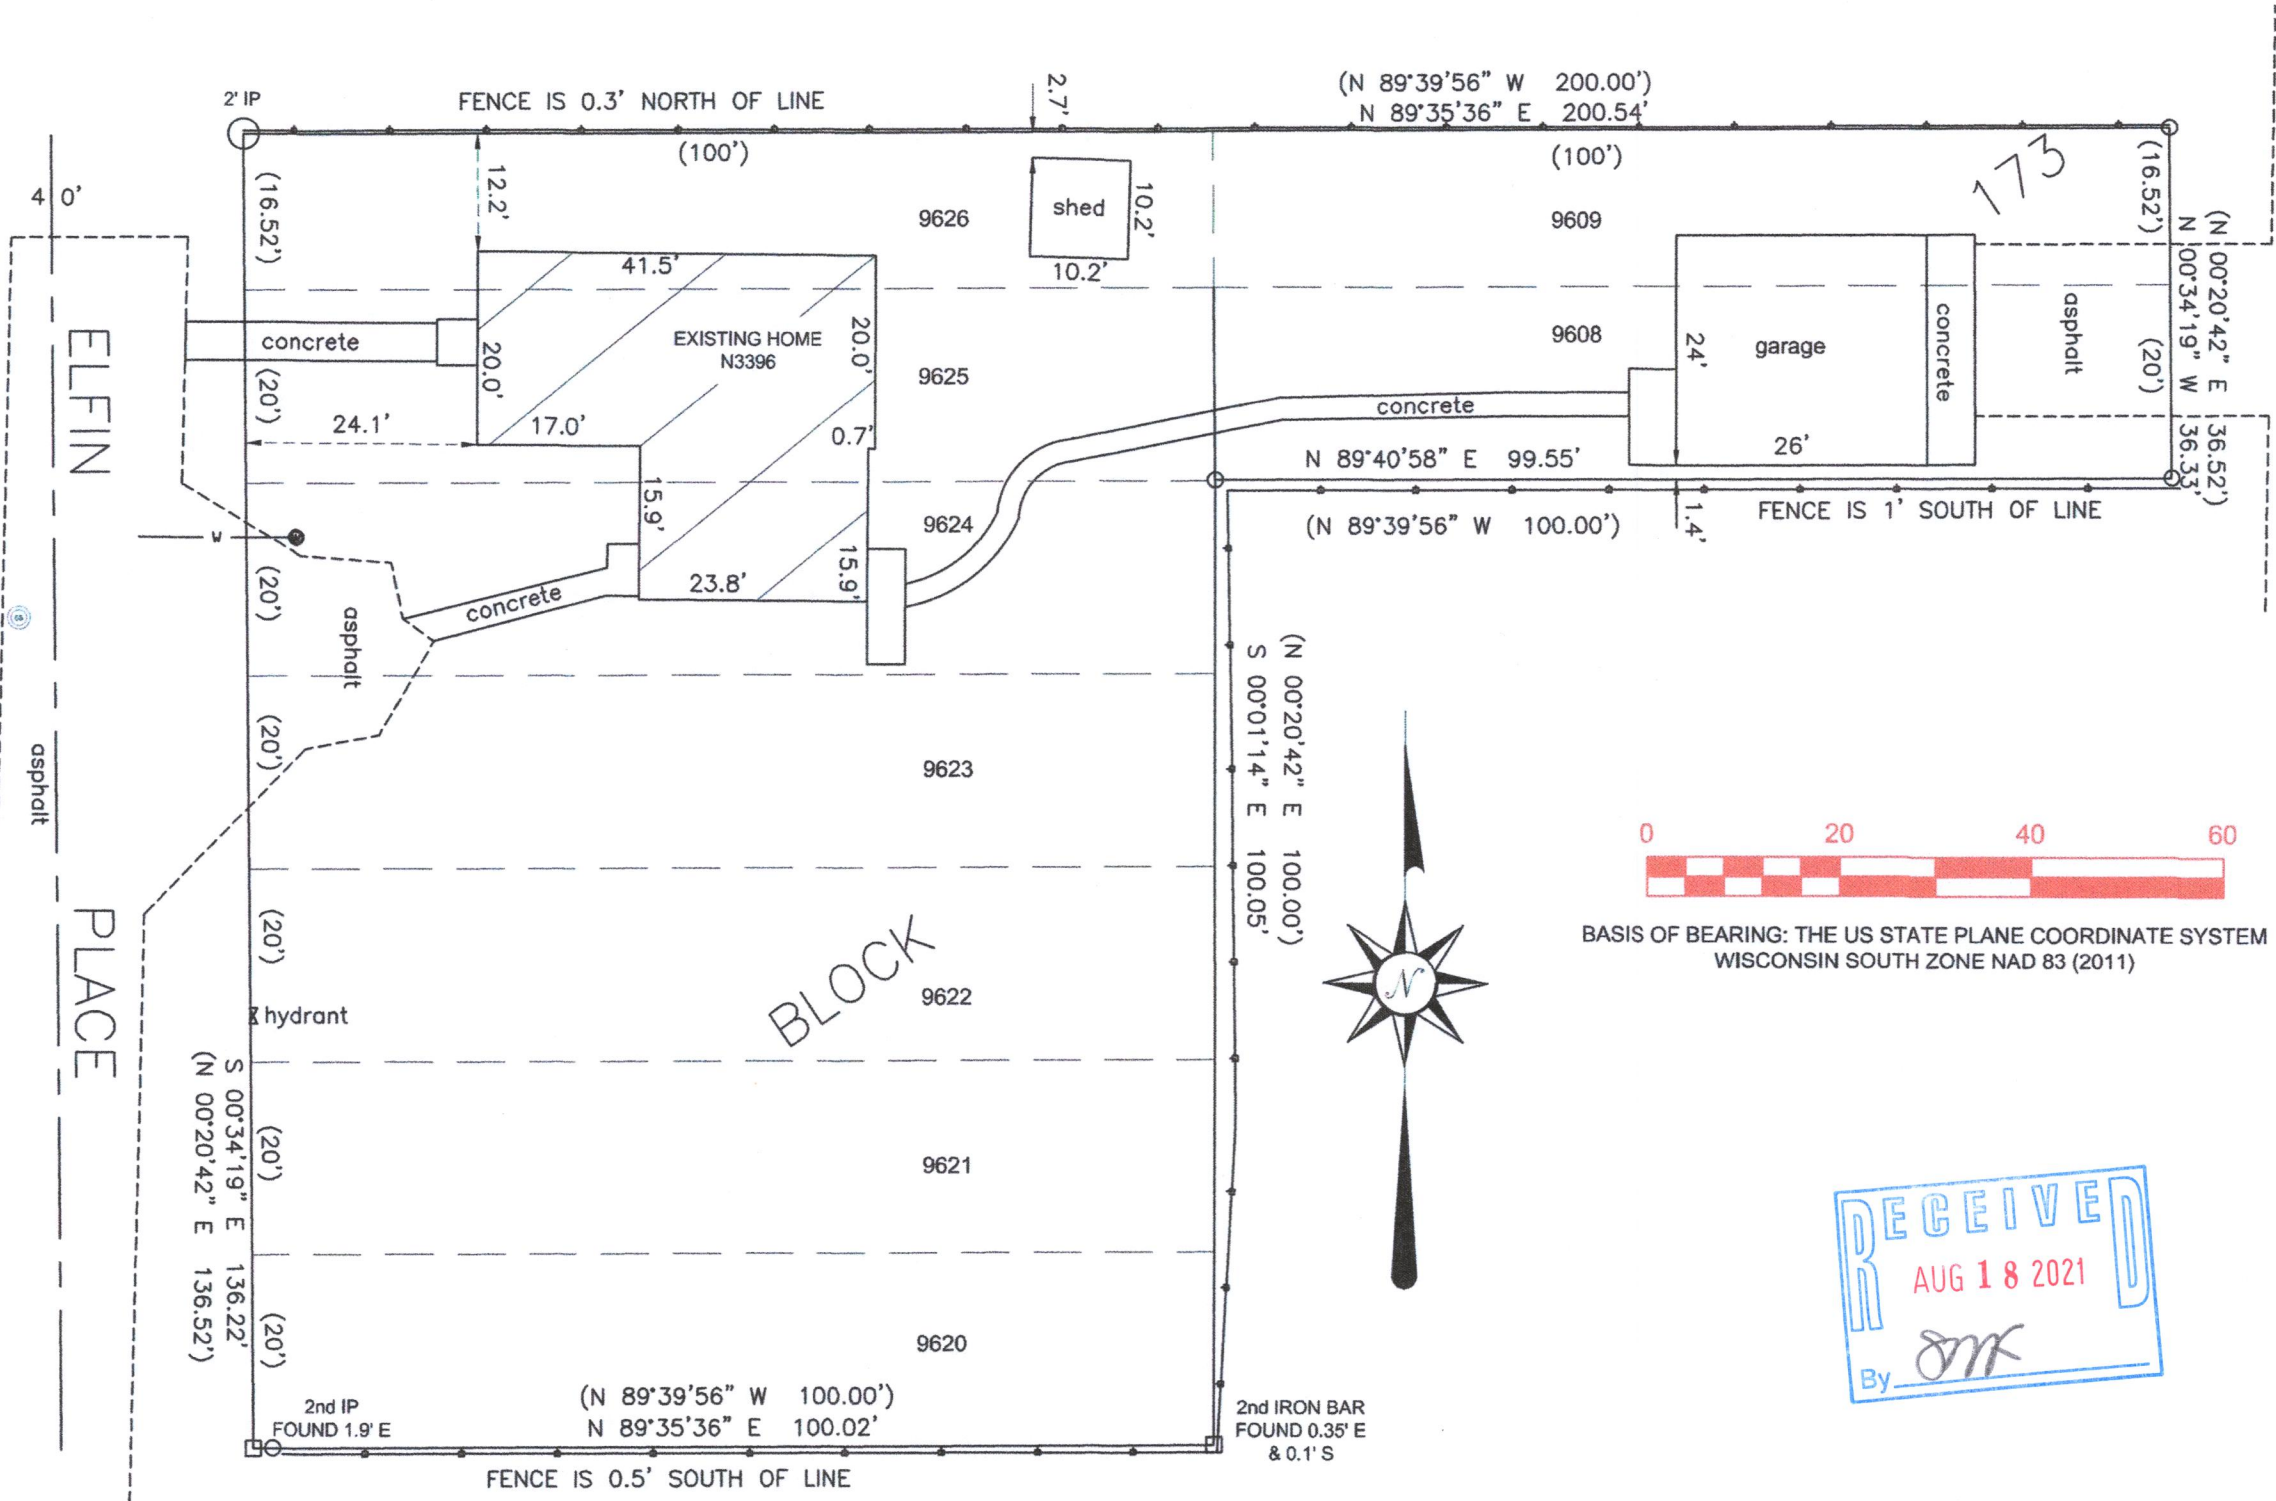


(XXX) = RECORDED AS
○ = FOUND IRON PIPE
□ = FOUND IRON BAR
SCALE 1" = 20'
JOB NO. 2021-037
TAX ID # JLCB 02075

I HEREBY CERTIFY THAT I HAVE SURVEYED THE ABOVE DESCRIBED PROPERTY AND THE ABOVE MAP IS A TRUE REPRESENTATION THEREOF AND SHOWS THE SIZE AND LOCATION OF THE PROPERTY, ITS EXTERIOR BOUNDARIES, THE LOCATION AND DIMENSIONS OF ALL STRUCTURES THEREON, FENCES, APPARENT EASEMENTS, ROADWAYS, AND VISIBLE ENCROACHMENTS, IF ANY.

THIS SURVEY IS MADE FOR THE PRESENT OWNERS OF THE PROPERTY, AND THOSE WHO PURCHASE, MORTGAGE, OR GUARANTEE THE TITLE THERETO WITHIN ONE YEAR FROM THIS DATE HEREOF.

DATED THIS 6TH DAY OF JULY 2021

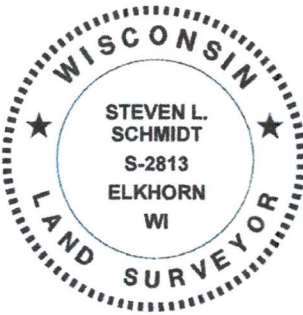

Steven L. Schmidt
STEVEN L SCHMIDT S - 2813
Wisconsin Professional Land Surveyor

217-4842