
LAND-MARK SURVEYING

Mark L. Miritz
Wisconsin Professional Land Surveyor S-2582

N9330 Knuteson Drive Whitewater, WI 53190 Phone: (262)495-3284 MARKMIRITZ@ LAND-MARKSURVEYING.COM

PLAT OF SURVEY

ORDERED BY: SAL DIMICELI JR. LAKE GENEVA AREA REALTY 101 BROAD STREET, SUITE C3 LAKE GENEVA, WI 53147 LOT 3, TRINITY MOUNTAIN ESTATES TOGETHER WITH AN EASEMENT FOR INGRESS AND EGRESS OVER AND ACROSS THE PRIVATE ROADS, IN TRINITY MOUNTAIN ESTATES, A SUBDIVISION LOCATED IN THE SOUTHEAST 1/4 OF SECTION 13 AND THE NORTHEAST 1/4 OF SECTION 24, TOWN 2 NORTH, RANGE 17 EAST, TOWN OF GENEVA, WALWORTH COUNTY, WISCONSIN.

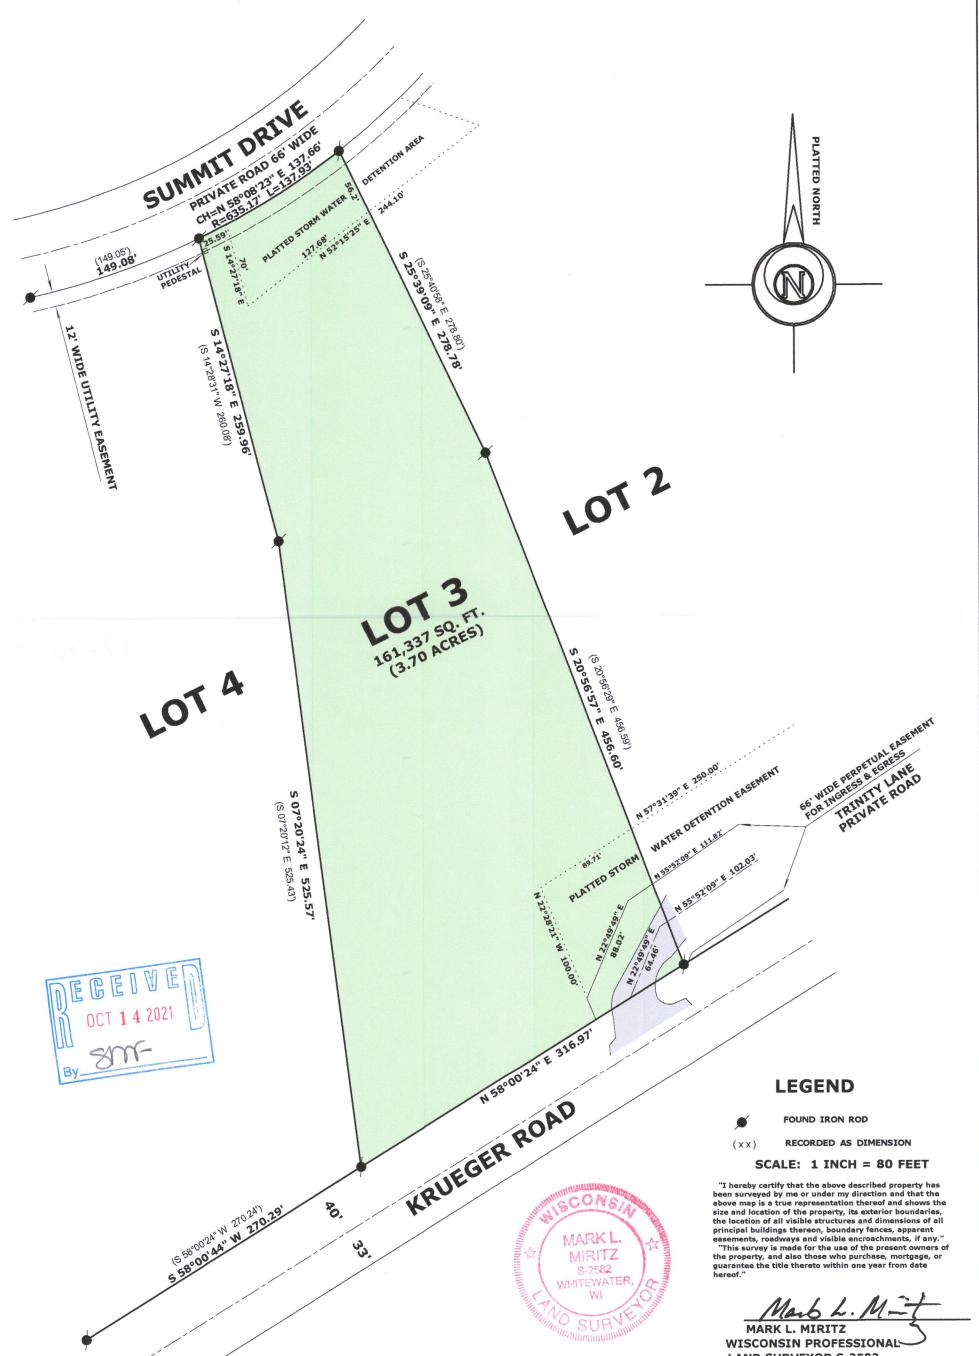

-3

17-4858

LAND SURVEYOR S-2582

DATE: SEPT. 22, 2021 JOB NO. 21.907