


# HAROLD H. KOLB

REGISTERED PROFESSIONAL LAND SURVEYOR  
LAKE GENEVA, WISCONSIN

WASHINGTON DRIVE 40' WIDE

CHERRY ROAD 40' WIDE

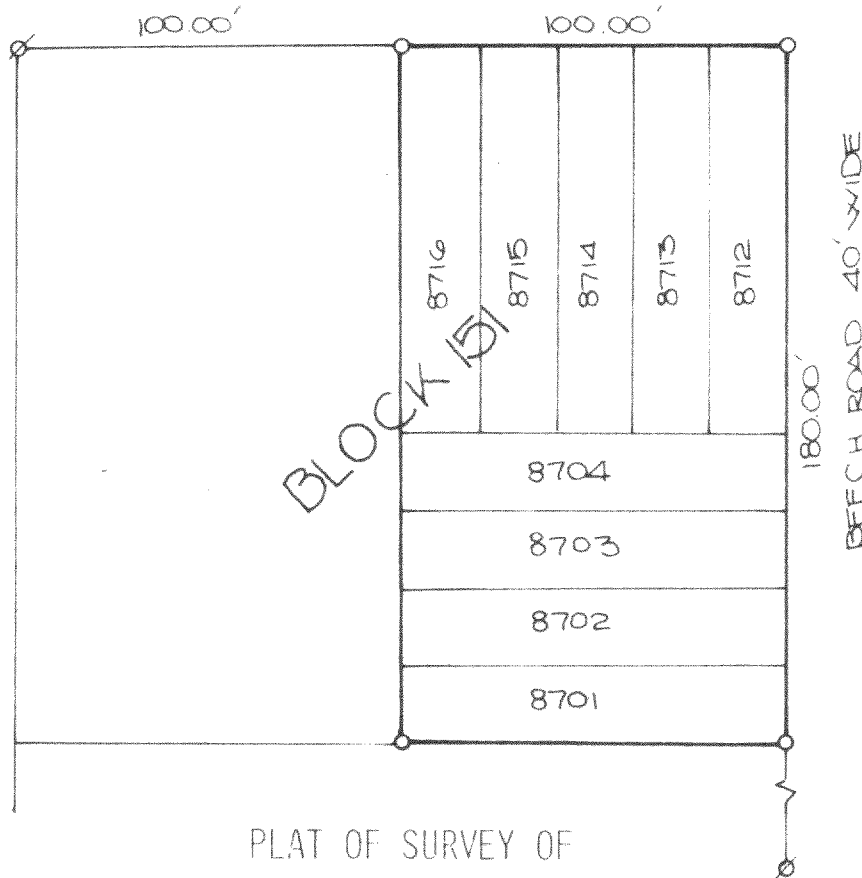

PLAT OF SURVEY OF

LOTS 8701-8704 AND 8712-8716, BLOCK 151, LAKE COMO  
BEACH SUBDIVISION, T2N, R17E, WALWORTH COUNTY, WIS.

N



SCALE 1"=50'

## LEGEND

- φ — IRON PIPE FOUND
- — IRON PIPE PLACED
- — CONCRETE MONUMENT
- x — SPIKE

OWNER: KAY OBET


ACCURACY: DISTANCES  $\pm 0.01'$   
ANGLES  $\pm 05''$   
ERROR OF CLOSURE — LESS  
THAN ONE PART IN 3000

I, HAROLD H. KOLB, DO HEREBY CERTIFY THAT I HAVE  
SURVEYED THE PROPERTY HEREON DESCRIBED ACCORDING  
TO THE OFFICIAL RECORDS, AND THAT THE PLAT HEREON  
IS A CORRECT REPRESENTATION OF THE LOT LINES.

*Harold H. Kolb*

HAROLD H. KOLB  
WISCONSIN REGISTERED LAND SURVEYOR, S-187

DATE Aug 20, 1976

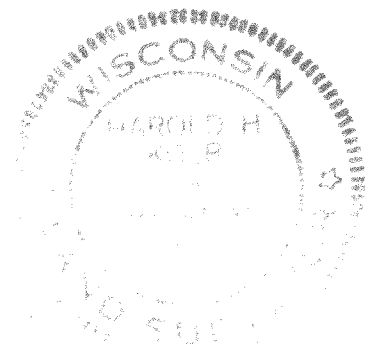

JLCB-1862

217-486