

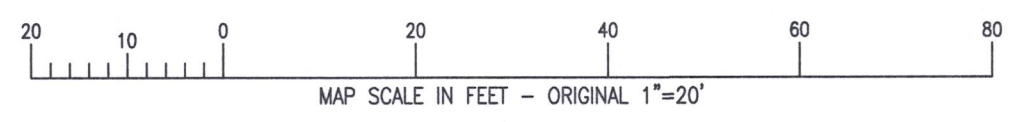
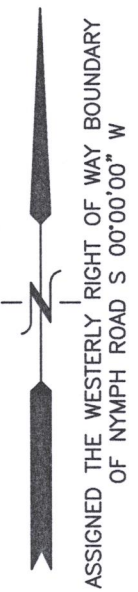


PLAT OF SURVEY
LOTS 7217 THROUGH 7226 OF BLOCK 124 OF LAKE COMO BEACH, A SUBDIVISION
LOCATED IN PART OF THE NE 1/4 OF THE NW 1/4 OF SECTION 28, TOWN 2 NORTH, RANGE 17 EAST, WALWORTH COUNTY, WISCONSIN

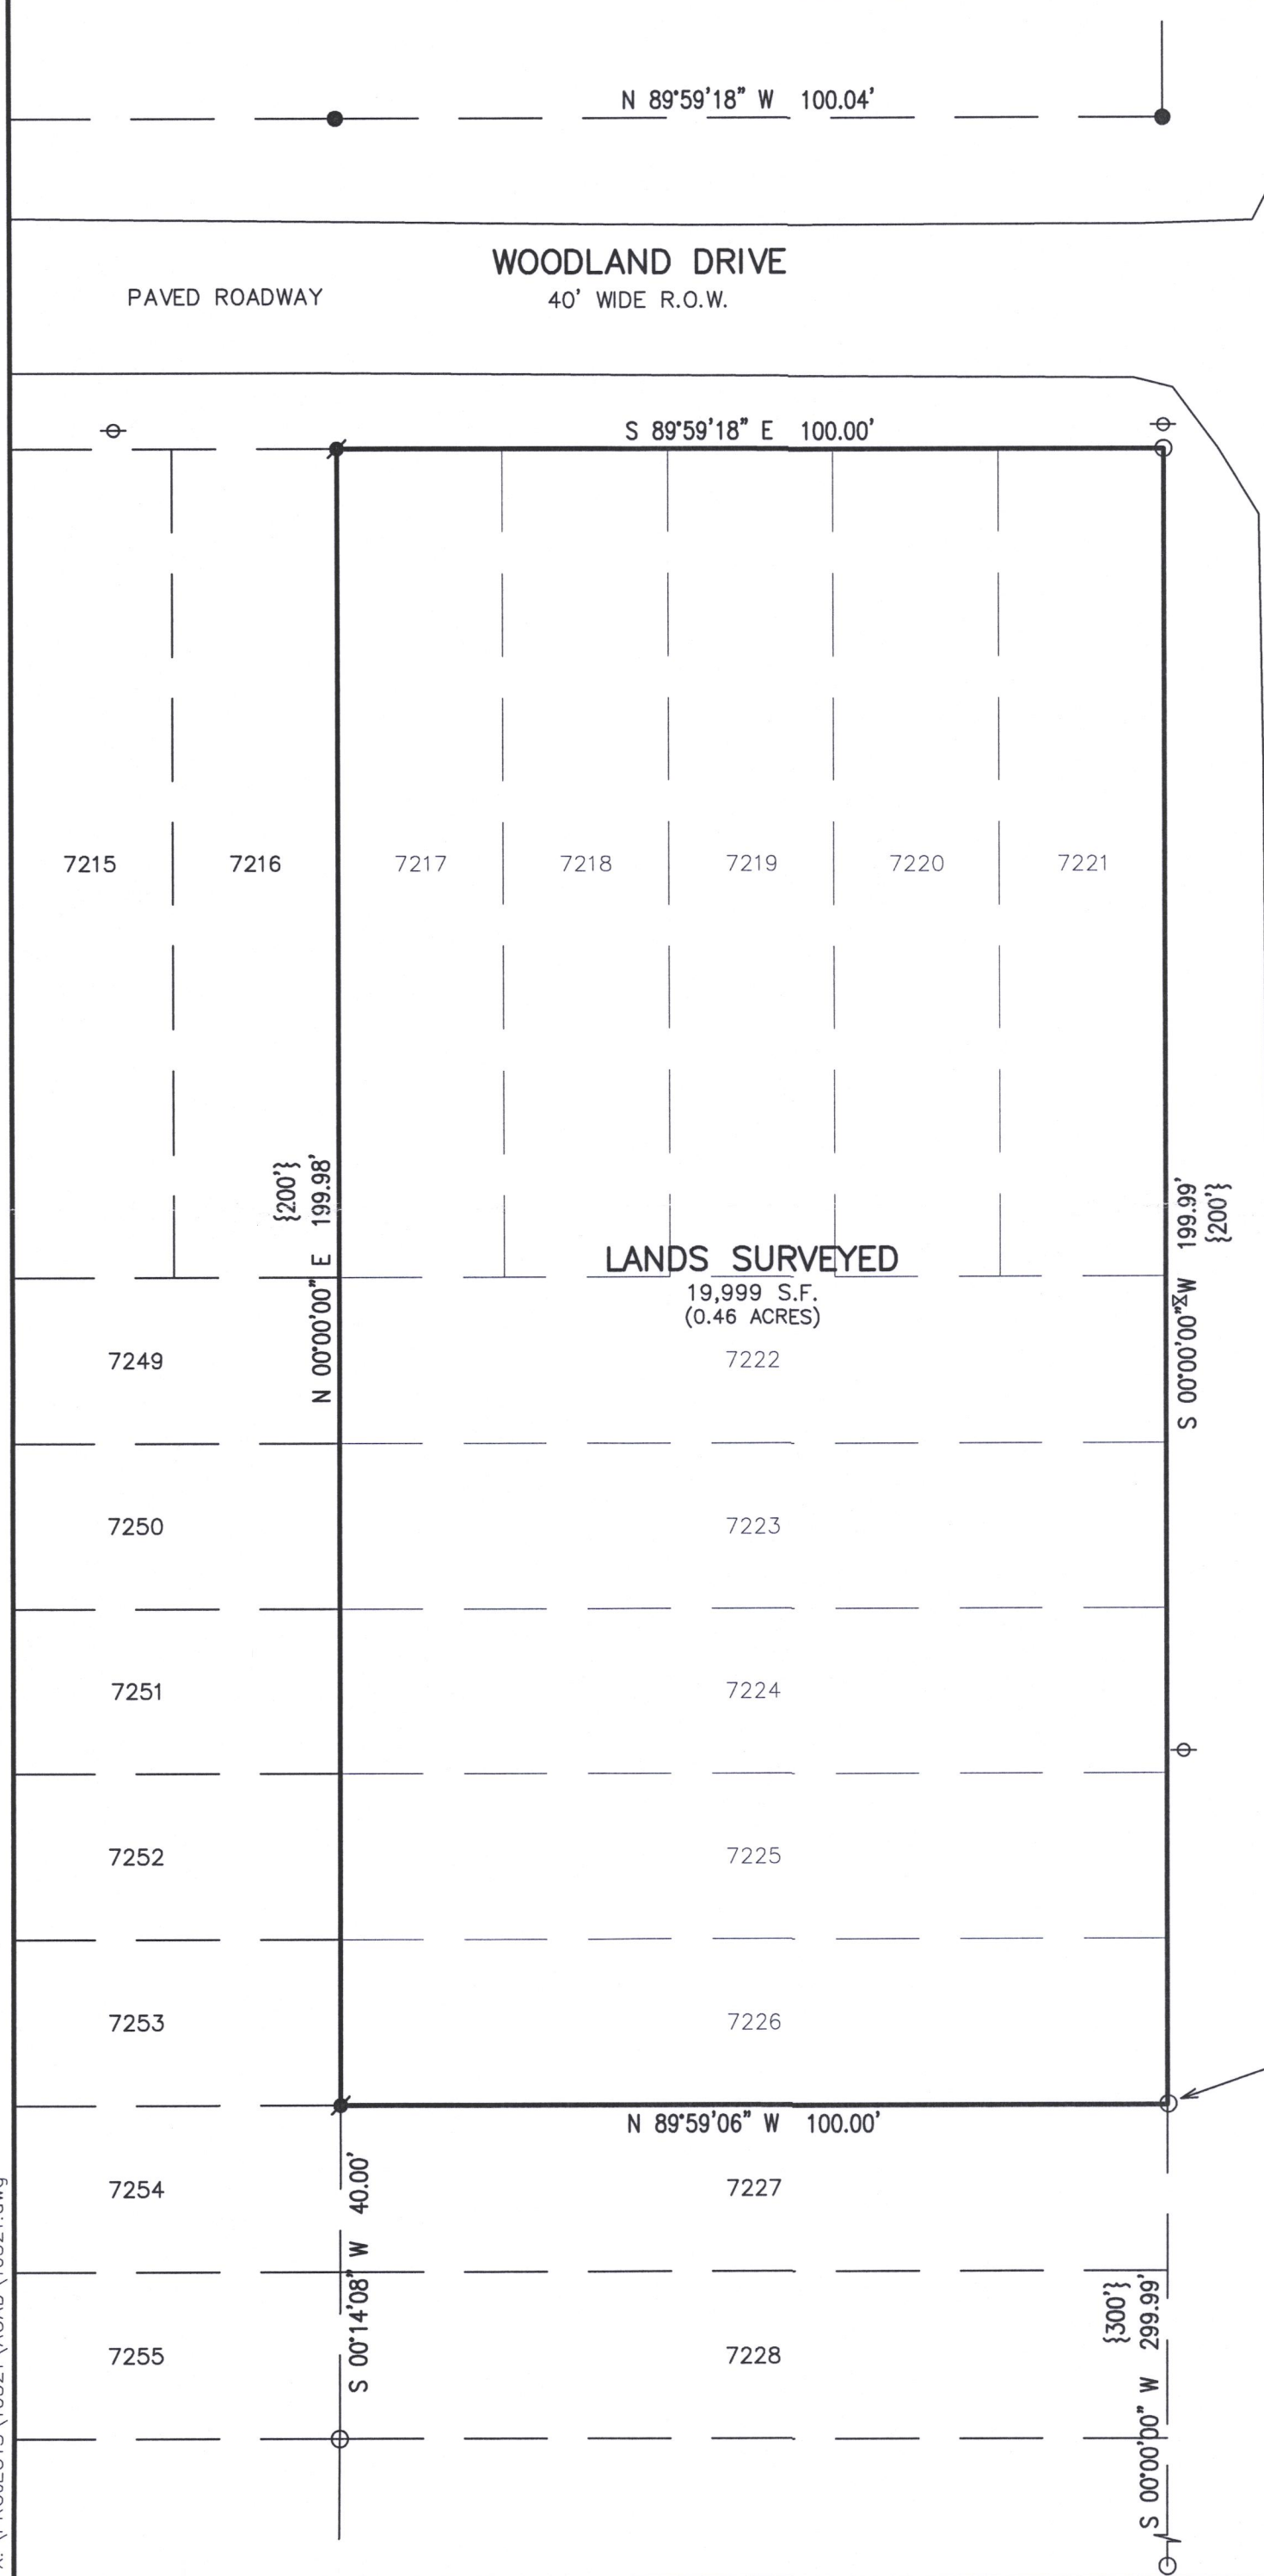

- LEGEND
- O = FOUND IRON PIPE STAKE
 - = FOUND IRON REBAR STAKE
 - ✕ = SET IRON REBAR STAKE
 - ⊕ = UTILITY POLE LOCATED
 - Ⓜ = SANITARY SEWER MANHOLE LOCATED
 - ⋈ = WATER VALVE LOCATED
 - {XXX} = RECORDED AS

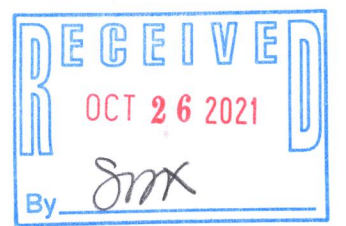

FOUND IRON PIPE STAKE
LEANING N 47°48'54" E
0.12' FROM RECORD CORNER

NOTE: COPIES OF THIS MAP TO WHICH THE FOLLOWING CERTIFICATE WILL APPLY SHOW THE SURVEYOR'S ORIGINAL SEAL AND SIGNATURE IN RED INK. COPIES BY ANY OTHER MEANS MAY HAVE ALTERATIONS WHICH DO NOT REPRESENT THE SURVEYOR'S WORK PRODUCT.

I HEREBY CERTIFY THAT THE ABOVE DESCRIBED PROPERTY HAS BEEN SURVEYED UNDER MY DIRECTION AND THAT THE ABOVE MAP IS A TRUE REPRESENTATION THEREOF AND SHOWS THE SIZE AND LOCATION OF THE PROPERTY AND ITS EXTERIOR BOUNDARIES. THIS SURVEY IS MADE FOR THE USE OF THE PRESENT OWNERS OF THE PROPERTY, AND ALSO THOSE WHO PURCHASE, MORTGAGE, OR GUARANTEE THE TITLE THERETO WITHIN ONE YEAR FROM THE DATE HEREOF.

DATED: 8/17/2021
Christopher A. Hodges
CHRISTOPHER A. HODGES P.L.S. 2760



PLAT OF SURVEY
LAKE GENEVA, WISCONSIN

WORK ORDERED BY -
HENRY LUCHERINI
1406 PRESIDENT STREET
GLENDALE HEIGHTS, IL 60139

FARRIS, HANSEN & ASSOCIATES, INC.
ENGINEERING - ARCHITECTURE - SURVEYING
7 RIDGWAY COURT P.O. BOX 437
ELKHORN, WISCONSIN 53121
OFFICE: (262) 723-2098 FAX: (262) 723-5886

REVISIONS

PROJECT NO.
10521
DATE:
08/17/2021
SHEET NO.
1 OF 1

X:\PROJECTS\10521\ACAD\10521.dwg

JLCB-1529

217-4868