
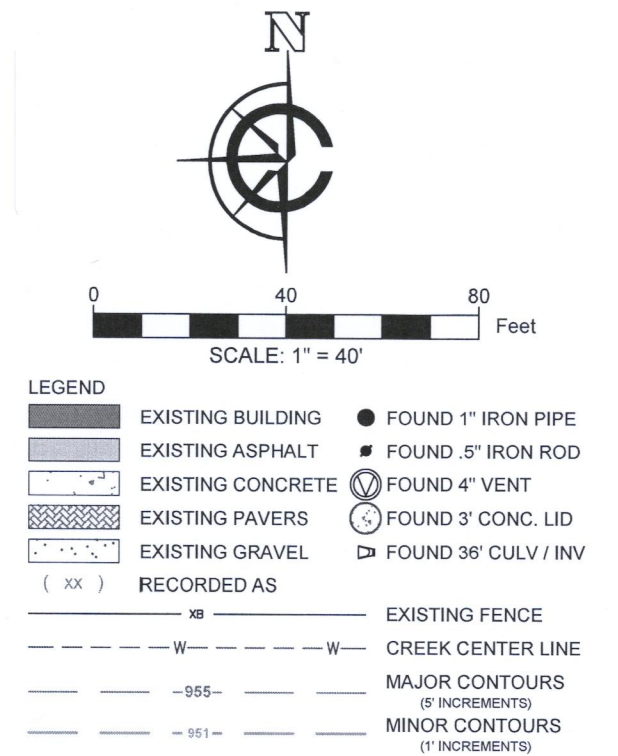


PLAT OF SURVEY

LEGAL DESCRIPTION:
PARCELS OF LAND LOCATED IN THE SOUTHWEST 1/4 OF THE
NORTHEAST 1/4 OF SECTION 34 IN TOWNSHIP 2 NORTH, RANGE 17
EAST, IN THE TOWN OF GENEVA, WALWORTH COUNTY, WISCONSIN.

MORE PARTICULARLY DESCRIBED AS:
LOT 23 OF WILDWOOD SUBDIVISION AS RECORDED IN DOCUMENT
NO. 575511 PER THE WALWORTH COUNTY REGISTER OF DEEDS;
ALSO INCLUDING OUTLOT 1 OF CERTIFIED SURVEY MAP 957 AS
RECORDED IN DOCUMENT NO. 50300 PER THE WALWORTH COUNTY
REGISTER OF DEEDS.

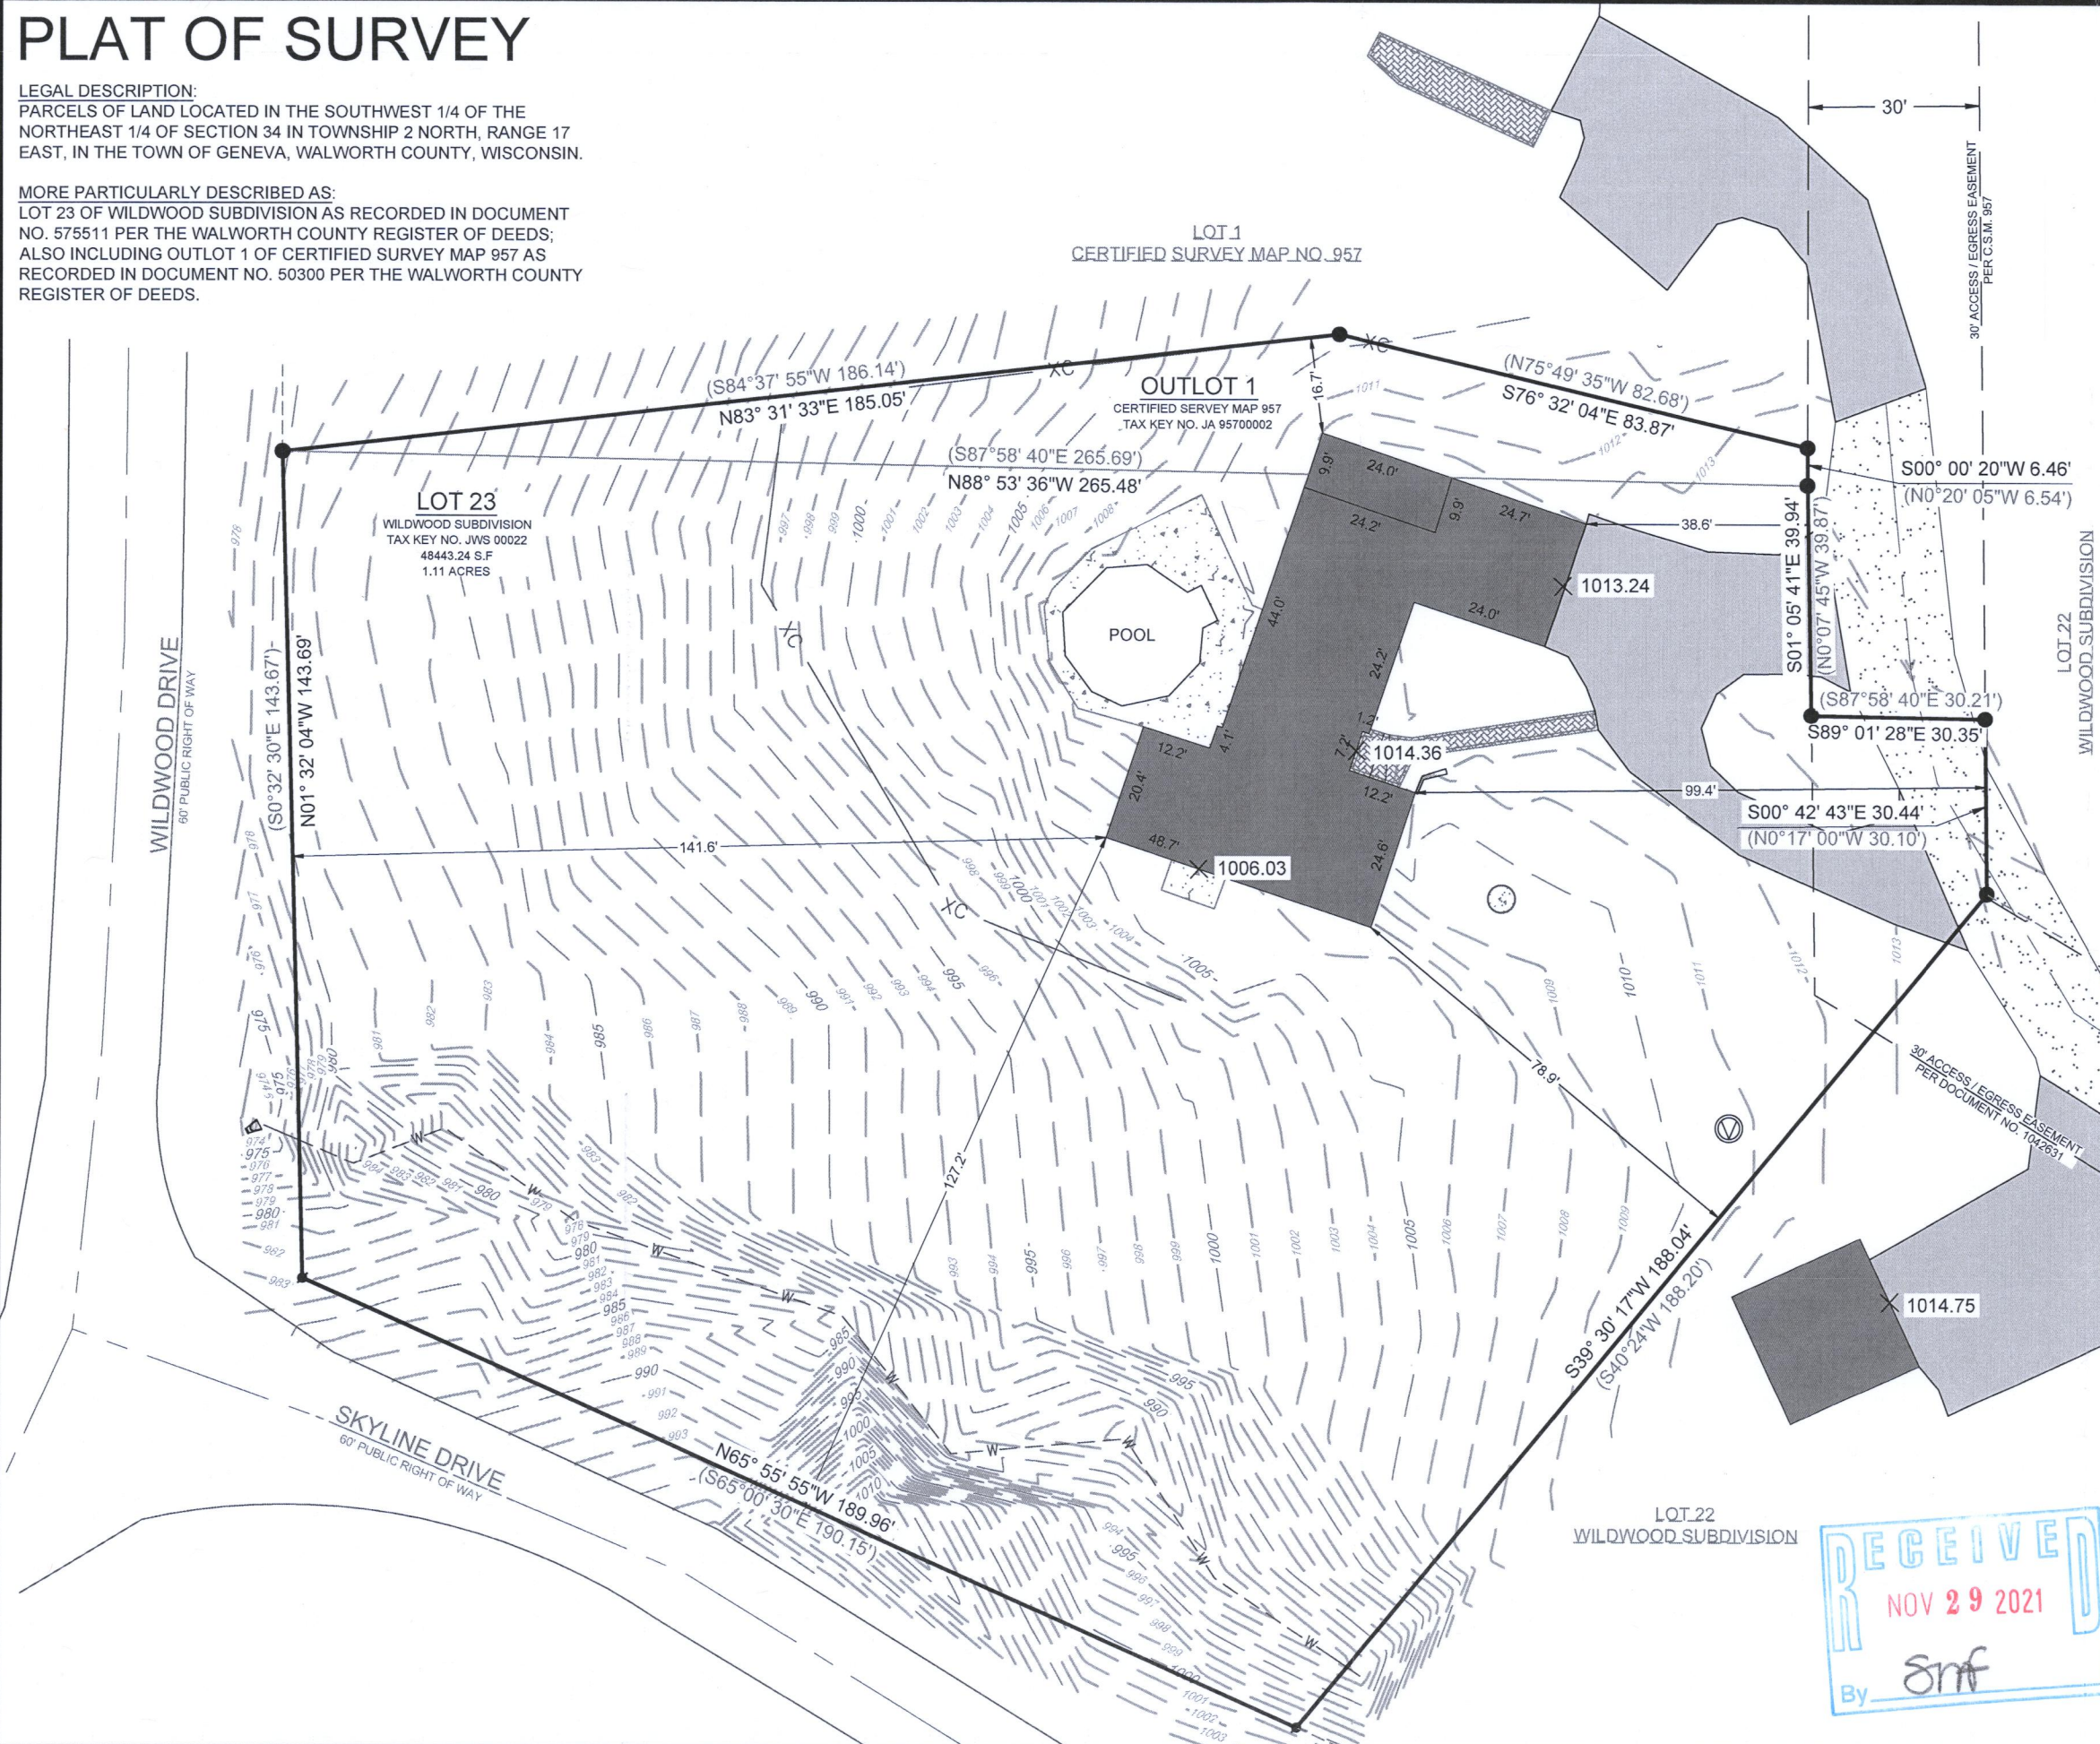

NOTE:

1. BASIS OF BEARING:
THE WISCONSIN STATE PLANE COORDINATE SYSTEM,
NAD-83, SOUTH ZONE.
 2. FIELD WORK COMPLETED ON:
NOVEMBER 2ND, 2021
 3. BUILDING SURVEYED TO:
THE EXTERIOR OF SIDING.
 4. FIELD CREW CHIEF:
RAYMOND MCARDLE
- SURVEY ORDERED BY:
IONEL AVERIAN
- PROPERTY ADDRESS:
N2732 SKYLINE DR.
LAKE GENEVA WI, 53147
- SURVEYOR:
PAUL H. VAN HENKELUM, PLS
CARDINAL ENGINEERING LLC

"I HEREBY CERTIFY THAT I HAVE SURVEYED THE ABOVE DESCRIBED PROPERTY
AND THE MAP IS A TRUE AND CORRECT REPRESENTATION OF ITS EXTERIOR
BOUNDARIES AND SHOWS THE SIZE AND LOCATION OF ALL VISIBLE STRUCTURES,
APPARENT EASEMENTS AND ENCROACHMENTS, IF ANY.

Paul H. Van Henkelum
PAUL H VAN HENKELUM, PLS #1931

11/17/2021
DATE



CARDINAL ENGINEERING LLC
DESIGNING IN TRUE DIRECTIONS

PO BOX 281 - 1200 LA SALLE ST.
LAKE GENEVA, WI 53147
262-757-8776
CARDINALENGINEERINGWI.COM

DATE: 11 / 17 / 2021 JOB No. 21542
SHEET 1 OF 1 LWG