


PLAT OF SURVEY
LOT 8 OF THE PRESERVE AT LAKEVIEW GLEN, A SUBDIVISION
LOCATED IN PART OF THE SW 1/4 OF THE SW 1/4
OF SECTION 32, TOWN 2 NORTH, RANGE 17 EAST,
TOWN OF GENEVA, WALWORTH COUNTY, WISCONSIN

BEARING BASIS PER RECORD PLAT OF
THE PRESERVE AT LAKEVIEW GLEN, A SUBDIVISION

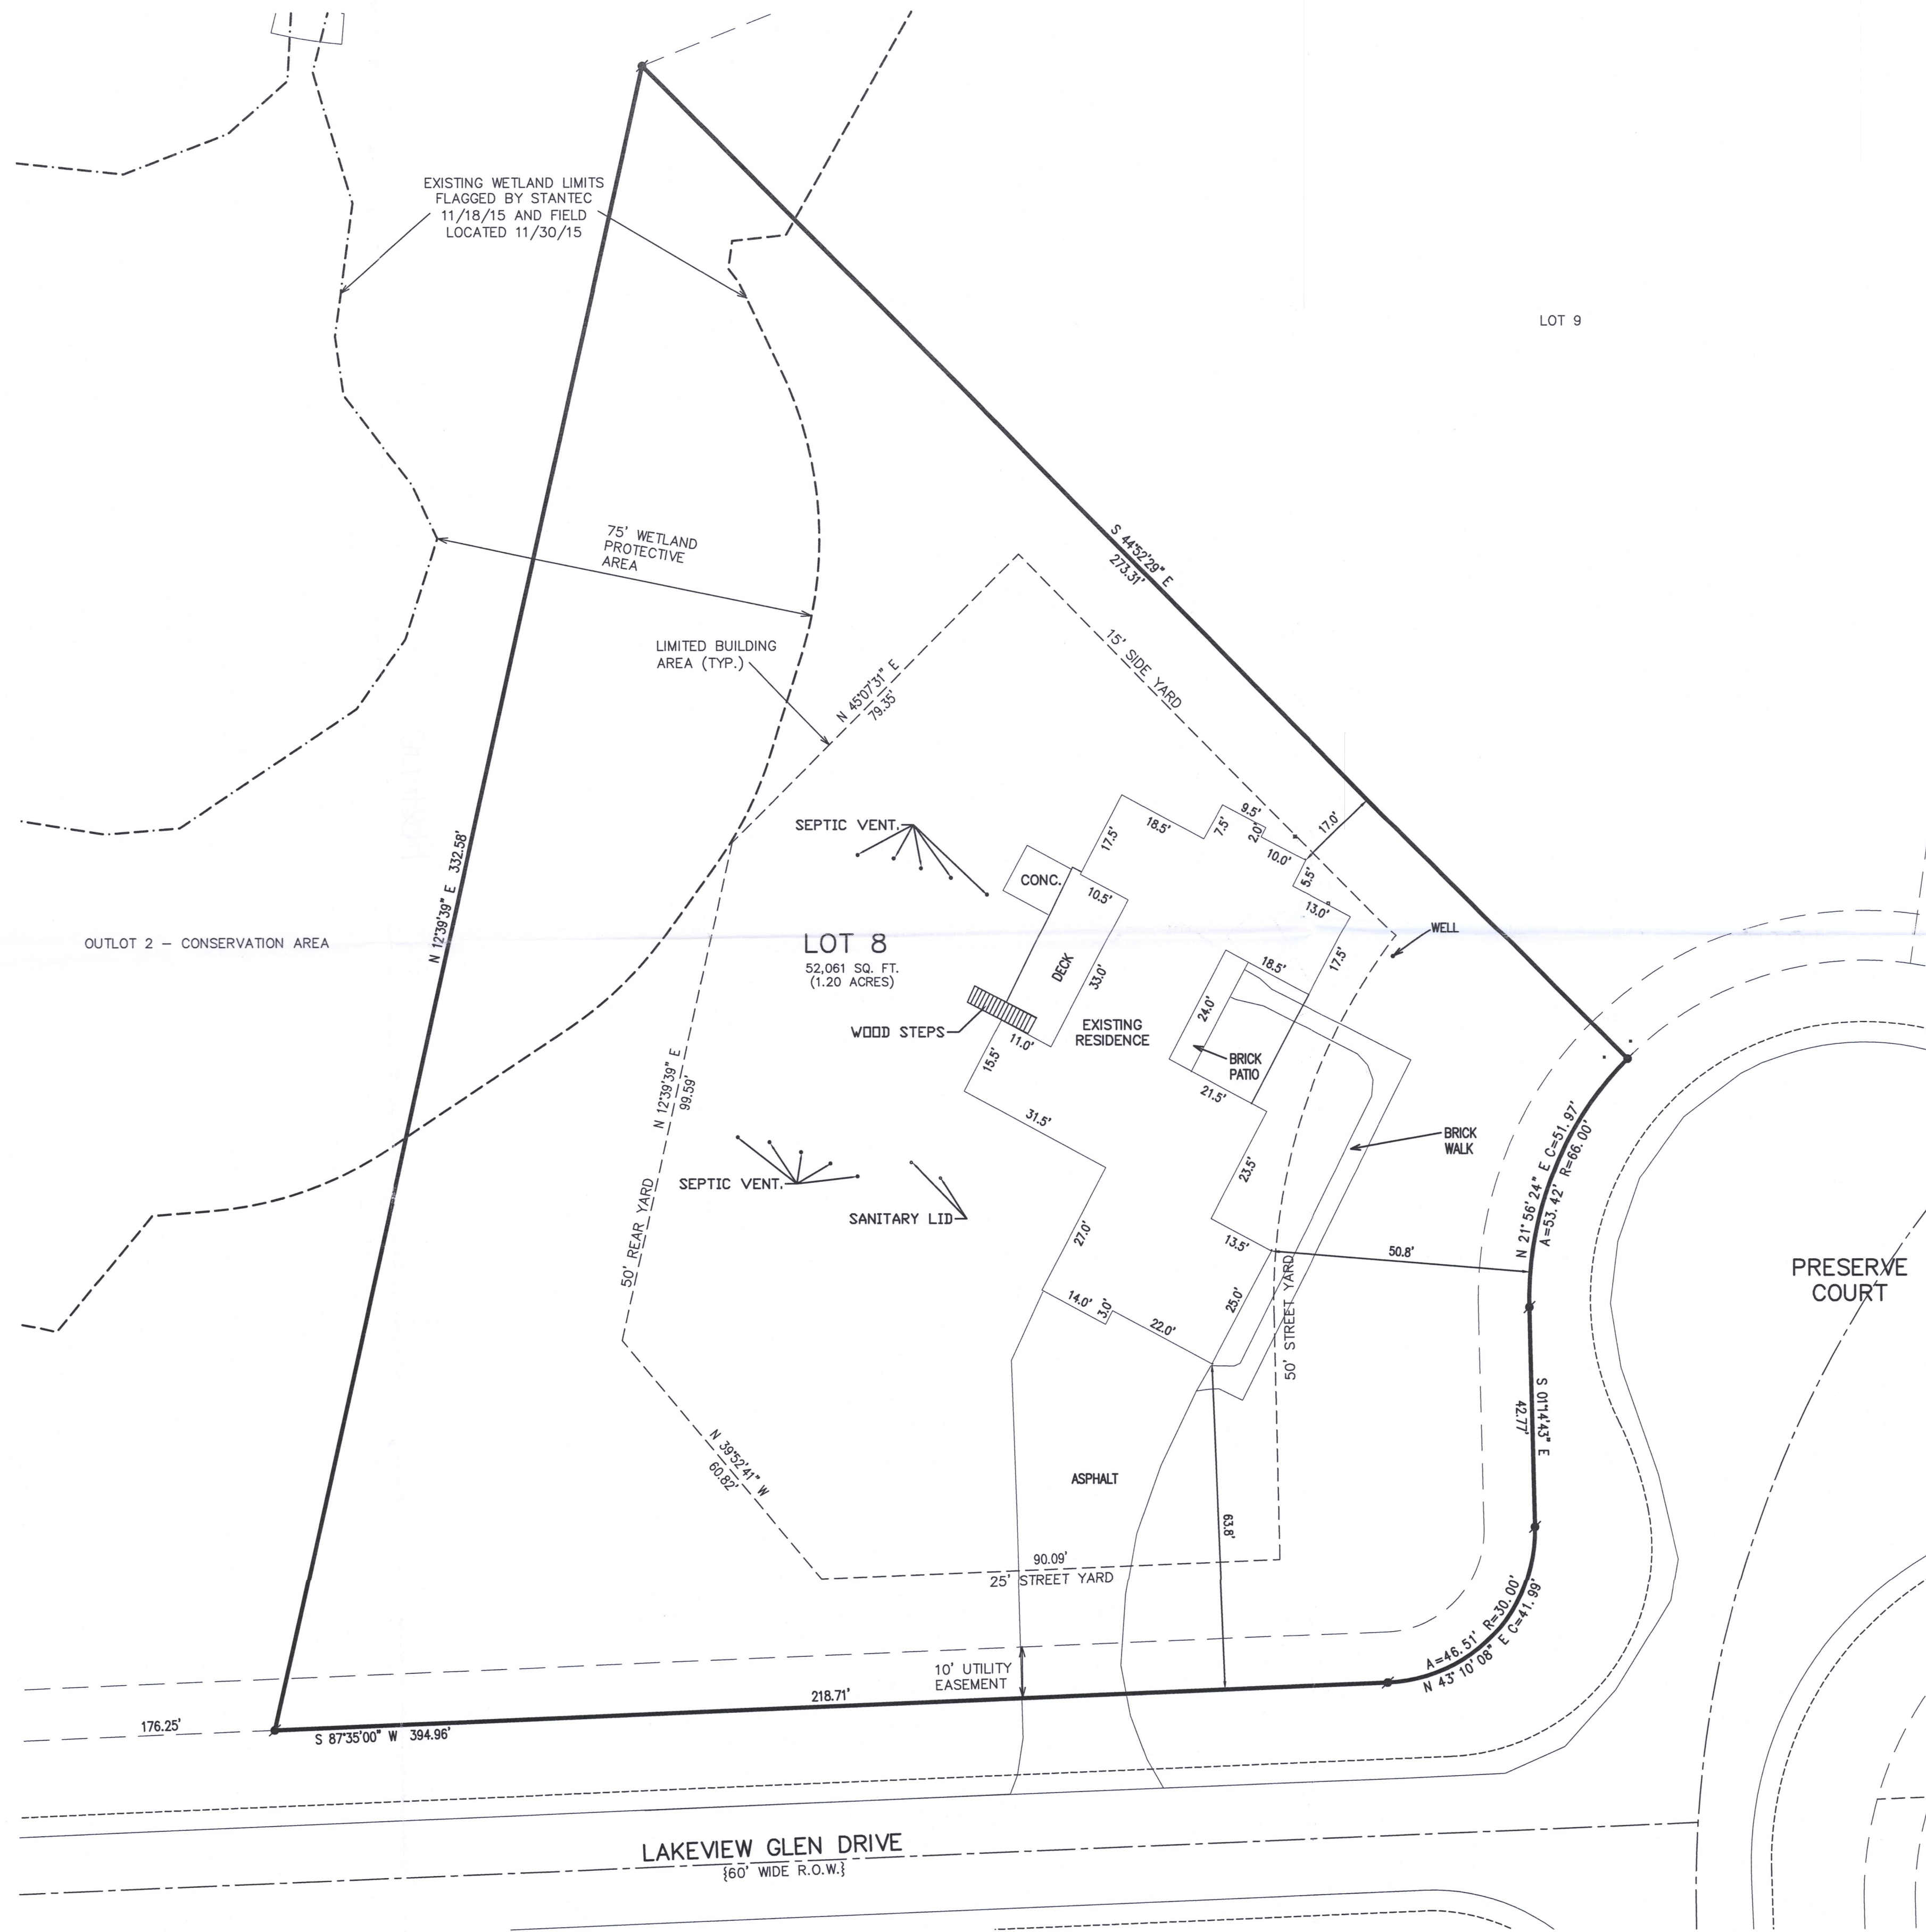


NOTE: COPIES OF THIS MAP TO WHICH THE FOLLOWING CERTIFICATE WILL APPLY SHOW
THE SURVEYOR'S ORIGINAL SEAL AND SIGNATURE IN RED INK. COPIES BY ANY OTHER
MEANS MAY HAVE ALTERATIONS WHICH DO NOT REPRESENT THE SURVEYOR'S WORK
PRODUCT.

I HEREBY CERTIFY THAT THE ABOVE DESCRIBED PROPERTY HAS BEEN SURVEYED
UNDER MY DIRECTION AND THAT THE ABOVE MAP IS A TRUE REPRESENTATION
THEREOF AND SHOWS THE SIZE AND LOCATION OF THE PROPERTY AND ITS EXTERIOR
BOUNDARIES. THIS SURVEY IS MADE FOR THE USE OF THE PRESENT OWNERS OF THE
PROPERTY, AND ALSO THOSE WHO PURCHASE, MORTGAGE, OR GUARANTEE THE TITLE
THERE TO WITHIN ONE YEAR FROM THE DATE HEREOF.

DATED: 10/21/2021

CHRISTOPHER A. HODGES P.L.S. S-2760

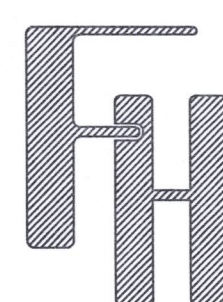


SITE PLAN

TOWN OF GENEVA,
WALWORTH COUNTY, WISCONSIN

WORK ORDERED BY -
MICHAEL CHORNEYKO
40W 304 LAFOX ROAD SUITE B
ST. CHARLES IL, 60175

FARRIS, HANSEN & ASSOCIATES, INC.
ENGINEERING - ARCHITECTURE - SURVEYING
7 RIDGWAY COURT P.O. BOX 437
ELKHORN, WISCONSIN 53121
OFFICE: (262) 723-2098 FAX: (262) 723-5886

REVISIONS
07/09/2020 - LK
SGDECP PREP.
07/16/2020 - LB
SGDECP
09/16/2020 - TS
REVISE PER COMMENTS

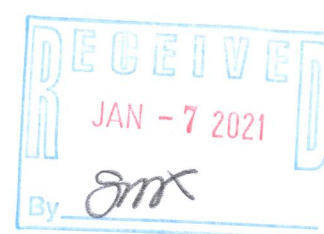

PROJECT NO.
9297.08
DATE
07/02/2020
SHEET NO.
1 OF 1

X:\PROJECTS\9297\INDV\LOTS\LOT_08\ACAD\9297-08.DWG



JPLG-8

017-4814