


PLAT OF SURVEY — AS BUILT
GENEVA NATIONAL CONDOMINIUM 16, UNIT 36
LOCATED IN PART OF THE NW 1/4 OF THE NE 1/4 OF SECTION 20, TOWN 2 NORTH, RANGE 17 EAST
TOWN OF GENEVA, WALWORTH COUNTY, WISCONSIN



LEGEND

- T.F. = TOP OF FOUNDATION ELEVATION
- F.F. = FIRST FLOOR ELEVATION
- G.E. = GARAGE ELEVATION
- L.L. = LOWER LEVEL ELEVATION
- W.O. = WALK OUT

TOTAL LAND DISTURBANCE: 11,200 SQ. FT.
(0.26 ACRES)

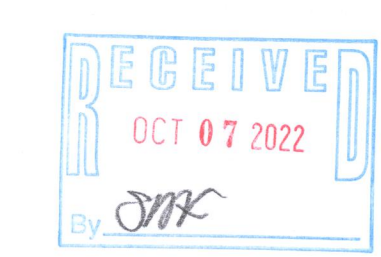


NOTE: COPIES OF THIS MAP TO WHICH THE FOLLOWING CERTIFICATE WILL APPLY SHOW THE SURVEYOR'S ORIGINAL SEAL AND SIGNATURE IN RED INK. COPIES BY ANY OTHER MEANS MAY HAVE ALTERATIONS WHICH DO NOT REPRESENT THE SURVEYOR'S WORK PRODUCT.

I HEREBY CERTIFY THAT THE ABOVE DESCRIBED PROPERTY HAS BEEN SURVEYED UNDER MY DIRECTION AND THAT THE ABOVE MAP IS A TRUE REPRESENTATION THEREOF AND SHOWS THE SIZE AND LOCATION OF THE PROPERTY AND ITS EXTERIOR BOUNDARIES. THIS SURVEY IS MADE FOR THE USE OF THE PRESENT OWNERS OF THE PROPERTY, AND ALSO THOSE WHO PURCHASE, MORTGAGE, OR GUARANTEE THE TITLE THERETO WITHIN ONE YEAR FROM THE DATE HEREOF.

DATED: 06/02/2021

CHRISTOPHER A. HODGES P.L.S. 2760

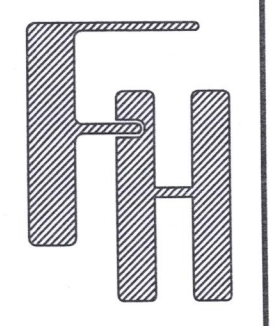

UNIT 36
GENEVA NATIONAL CONDOMINIUM NO. 16
168 1/2 RYDER CUP DRIVE
TOWN OF GENEVA, WALWORTH COUNTY, WISCONSIN

— WORK ORDERED BY —
OMEGA HOMES, LLC
210 EAST O'CONNOR DRIVE, SUITE 101
ELKHORN, WI 53121

FARRIS, HANSEN & ASSOCIATES, INC.
ENGINEERING — ARCHITECTURE — SURVEYING
7 RIDGWAY COURT P.O. BOX 437
ELKHORN, WISCONSIN 53121
OFFICE: (262) 723-2098 FAX: (262) 723-5886

| REVISIONS | |
|-----------------|--------------------------|
| 05/27/2021 — TS | SUBJECT |
| 06/02/2021 — TS | ADD DIMENSIONS |
| 05/09/2022 — TS | REVISE BUILDING LOCATION |
| 05/11/2022 — TS | ADVANCE |
| 8/22/2022 — BHC | AS-BUILT INFORMATION |

PROJECT NO.
3269.16.36
DATE
12/20/2016
SHEET NO.
1 OF 1

212 5013